



**Pacific Gas and  
Electric Company**

**Yvonne J. Meeks**  
Site Remediation – Portfolio Manager  
Environmental Affairs

6588 Ontario Road  
San Luis Obispo, CA 93405

Mailing Address  
4325 South Higuera Street  
San Luis Obispo, CA 93401

805.546.5243  
Internal: 644.5243  
Fax: 805.546.5232  
Email: [YJM1@pge.com](mailto:YJM1@pge.com)

July 29, 2005

Mr. Norman Shopay  
Project Manager  
California Department of Toxic Substances Control  
Geology and Corrective Action Branch  
700 Heinz Avenue  
Berkeley, California 94710

Subject: Final Design Plan – Conveyance Piping and Power Supply for Extraction Well PE-1, Topock Compressor Station, Needles, California.

Dear Mr. Shopay:

This letter transmits the final design plan for the conveyance piping and power supply for extraction well PE-1 at the Pacific Gas and Electric Company (PG&E) Topock site. The final design plan reflects the suggestions from the United States Bureau of Land Management (BLM) and California Department of Toxic Substances Control (DTSC) for the pipeline route proposed in the draft design plan submitted to DTSC and BLM in March 2005.

If you have any questions, please do not hesitate to contact me. I can be reached at (805) 546-5243.

Sincerely,

*Yvonne Meeks* for Yvonne Meeks

---

*Final*

**Design Plan  
Conveyance Piping and Power Supply  
for Extraction Well PE-1**

**Topock Compressor Station  
Needles, California**

Prepared for  
**California Department of Toxic Substances Control**

On behalf of  
**Pacific Gas and Electric Company**

July 2005



*Final*

**Design Plan**  
**Conveyance Piping and Power Supply**  
**for Extraction Well PE-1**  
**Topock Compressor Station**  
**Needles, California**

July 2005

**Prepared for**  
California Department of Toxic Substances Control  
**On behalf of**  
Pacific Gas and Electric Company

**Prepared by**  
CH2M HILL

This document was prepared by CH2M HILL under the supervision of:



---

Douglas W. Landfear, P.E.  
Project Engineer

CH2M HILL  
155 Grand Avenue, Suite 1000  
Oakland, California 94612

July 2005

# Contents

---

<b>Acronyms and Abbreviations .....</b>	<b>iii</b>
<b>1.0 Introduction.....</b>	<b>1-1</b>
1.1 Authorizations .....	1-1
<b>2.0 Design Plan.....</b>	<b>2-1</b>
2.1 Referenced Drawings.....	2-1
2.2 Groundwater Extraction System for Extraction Well PE-1 .....	2-2
2.2.1 Extraction Well Design Pump Rate.....	2-2
2.2.2 Well Pump .....	2-3
2.2.3 Well Vault.....	2-3
2.2.4 Conveyance and Conduit Systems .....	2-3
2.2.5 Instrumentation and Controls .....	2-4
2.3 Construction Access and Work Limits .....	2-4
<b>3.0 Mitigation Measures.....</b>	<b>3-1</b>
<b>4.0 Construction Schedule .....</b>	<b>4-1</b>
<b>5.0 Required Permits and Approvals.....</b>	<b>5-1</b>
<b>6.0 References .....</b>	<b>6-1</b>

## Tables

- 1 Referenced Drawings for PE-1
- 2 Permits, Approvals, and Certifications for Extraction Wells

## Appendix

- A Drawings for PE-1

# Acronyms and Abbreviations

---

BLM	United States Bureau of Land Management
Cr(VI)	hexavalent chromium
DTSC	California Department of Toxic Substances Control
gpm	gallons per minute
IM	Interim Measures
µg/L	micrograms per liter
PE-1	potential extraction well no. 1
PG&E	Pacific Gas and Electric Company

# 1.0 Introduction

---

Pacific Gas and Electric Company (PG&E) is addressing chromium in groundwater at the Topock Compressor Station in Needles, California, under the oversight of the California Department of Toxic Substances Control (DTSC). In a letter dated February 16, 2005, DTSC directed PG&E to install a new groundwater extraction well in the Colorado River floodplain at the site (DTSC 2005a). The directive was issued as a result of the detection of hexavalent chromium [Cr(VI)] in a sample collected from monitoring well MW-34-100 at a concentration of 357 micrograms per liter ( $\mu\text{g/L}$ ) in February 2005. Well MW-34-100 is located on the Colorado River floodplain, approximately 600 feet east of the location of the existing groundwater extraction well TW-2D and the treatment facilities operated as part of Interim Measures (IM) No. 2. Well MW-34-100 monitors the deep portion of the Alluvial Aquifer.

On February 23, 2005, PG&E submitted a work plan to the DTSC and United States Bureau of Land Management (BLM) to site, install, and test a new extraction well, referred to as potential extraction (PE) well PE-1, in the Colorado River floodplain (CH2M HILL 2005a). The DTSC and BLM conditionally approved the extraction well work plan on February 25, 2005 (DTSC 2005b; BLM 2005). Exploratory borings and drilling activities began on February 26, 2005, and the PE-1 was installed on March 5, 2005. The BLM directed PG&E to complete the new extraction well by March 15, 2005 to avoid potential impacts to wildlife and any local or transient threatened or endangered species (e.g., Willow Flycatcher) that could occur within this project area.

On March 4, 2005, PG&E submitted a request for DTSC and BLM approval to design and install piping, well vaults, and power supply for the new extraction well. A draft design plan was submitted to DTSC on March 21, 2005 that provided the details for the new extraction well and facilities. Two site walks were held with BLM and DTSC representatives on May 5 and June 9, 2005 to review the pipeline alignment. In July 2005, DTSC requested that PG&E submit this final design package for the PE-1 pipeline.

## 1.1 Authorizations

The extraction well, conveyance piping, and power supply will be installed on BLM-managed property. BLM has authorized this activity under an Action Memorandum, dated March 3, 2004 (BLM 2004). Section V of this Action Memorandum requires BLM review and approval of such work before implementation so that appropriate mitigation measures can be identified, and any concerns for biological or cultural resources can be addressed for the proposed work area. Cultural resource survey(s) conducted in 2004 did not identify any cultural resources in the Colorado River floodplain (CH2M HILL 2004a). All activities associated with piping and power installation will be coordinated with BLM to protect resources.

## 2.0 Design Plan

---

Two potential extraction wells, including a floodplain extraction well, PE-1, were included in the IM No. 3 *Thirty Percent Design Submittal, Interim Measures No. 3, PG&E, Topock Compressor Station, Needles, California* (CH2M HILL 2004b) that was conditionally approved for construction in a DTSC letter dated September 21, 2004 (DTSC 2004).

This design plan describes the updated design criteria for extraction well PE-1 and describes the facilities that will be constructed in the Colorado River floodplain to convey extracted groundwater to the IM No. 3 treatment plant (or IM No. 2 batch plant).

### 2.1 Referenced Drawings

Appendix A contains drawings showing details of the conveyance piping, instrumentation and controls, and power supply for extraction well PE-1. The attached drawings are part of a comprehensive drawing package for the IM No. 3 treatment plant that currently consists of over 130 individual drawings. As such, drawing numbers, revision dates (due to ongoing construction changes), and supplemental information not specific to extraction well PE-1 may be included on the drawings provided in this design plan. As part of the design-build approach for the IM No. 3 project, certain details and field modifications will be developed as construction progresses and will be documented as design modifications and in the as-built drawings for the IM No. 3 project.

Table 1 lists the drawings included as part of this submittal that are specifically related to PE-1.

**TABLE 1**  
Referenced Drawings for PE-1  
*PG&E Topock Compressor Station, Needles, California*

Drawing No.	Title	Description
SK-TP-PE1-1	Plan View – Proposed PE-1 Pipeline Route	Sketch of pipeline alignment over aerial photography collected in 2004. Show the alignment in relation to site vegetation. Not a construction drawing.
TP-PC-10-01-07	Piping Plan and Profile	Shows the proposed piping alignment from extraction well PE-1 to Valve Vault #1 at the MW-20 bench.
TP-PC-10-10-08	Detail Sheet 1	Shows a typical trench detail for a single double-contained pipe. Also includes a typical detail for a leak detection sensor station.
TP-EE-20-01-24	PE-1 Electrical Conduit Route	Shows the route of the electrical conduit in the same trench as the piping.



**TABLE 1**  
Referenced Drawings for PE-1  
*PG&E Topock Compressor Station, Needles, California*

<b>Drawing No.</b>	<b>Title</b>	<b>Description</b>
TP-SE-20-00-15	PE-1 Well Vault #3 Sections and Details – Sheet 1	Shows the well vault for extraction well PE-1 (referred to as well vault #3).
TP-PI-20-02-02	Underground Piping - Extraction Wells TW-2D and TW-2S Well Vaults, Bench Site 20 Valve Vault	Shows the piping running from PE-1 into Valve Vault #1 at the MW-20 bench.
TP-PI-20-02-06	Extraction Wells – PE-1 Well Vault	Shows the piping in the PE-1 well vault.
TP-PR-10-10-03	Process and Instrumentation Diagram - Extraction Wells PE-1, PE-1, TW-2D, and TW-2S	Process and Instrumentation Diagram for extraction well PE-1.

## 2.2 Groundwater Extraction System for Extraction Well PE-1

The groundwater extraction system for PE-1 consists of an extraction well, well pump, conveyance piping, power supply, and instrumentation and controls. The following sections describe the facilities to be installed to convey water from PE-1 to Valve Vault #1 on the MW-20 bench. Valve Vault #1 is designed to combine flows from each extraction well (TW-2D, TW-2S, and PE-1) to the IM No. 3 treatment plant. This vault is also designed to accommodate flows from future extraction wells if necessary.

### 2.2.1 Extraction Well Design Pump Rate

Extraction Well PE-1 is located in the Colorado River floodplain approximately 75 feet east of the MW-36 cluster. The extraction well was installed in early March 2005 after DTSC and BLM approved of the extraction well work plan. The extraction well was constructed with 6-inch schedule 40 polyvinyl chloride well casing that extends to the ground surface. Based on concurrence from DTSC, the extraction well was screened over a 10-foot interval from approximately 79 feet to 89 feet below ground surface. The well screen was a 6-inch-diameter type 304 stainless-steel screen with 0.060-inch slot size. Initial testing of PE-1 was completed during well development on March 5, 2005. The extraction well pumping capacity was tested for short durations (up to 30 minutes) at flow rates from 10 to 40 gallons per minute (gpm). The specific capacity at these flow rates ranged from 0.75 to 1 gpm per foot of drawdown in the well. The well installation and initial testing of PE-1 was documented in a field summary report submitted to the DTSC April 2005 (CH2M HILL 2005b).

Based on the results of initial testing, a design maximum pumping rate of 40 gpm is proposed for PE-1.

### 2.2.2 Well Pump

Extraction well PE-1 will be equipped with a Grundfos Model 40S50-12 submersible pump with a rated capacity of 40 gpm capable of conveying extracted groundwater to the IM No. 3 treatment plant. The well pump will be installed at the mid-point of the well screen, approximately 84 feet below ground surface.

### 2.2.3 Well Vault

The extraction well will be completed within a subsurface pre-cast concrete well vault (Well Vault #3). This vault is similar to that to be installed at TW-2D and TW-2S. The well vault is approximately 7 feet wide, 10 feet long, and 7 feet deep to accommodate the underground double-wall conveyance piping and associated valves and fittings. Drawing TP-SE-20-00-15 depicts the well vault dimensions.

### 2.2.4 Conveyance and Conduit Systems

Underground piping and electrical and control conduits will be connected to the well head to (1) convey extracted water from PE-1 to Valve Vault #1 on the MW-20 bench and (2) provide power and control for the pump and instrumentation. The alignment and profile for the piping and conduits that will be installed between the Well Vault #3 and Valve Vault #1 on the MW-20 bench is shown on Drawing TP-PC-10-01-07. The length of the alignment is approximately 500 feet. The alignment includes suggestions by BLM during site walks to avoid native vegetation (e.g., mesquite trees) and reduce the removal of non-native salt cedar that serves as potential nesting habit for the southwestern willow flycatcher.

Extracted groundwater will be conveyed in double-contained high-density polyethylene pipeline (3-inch-diameter pipe contained within a 6-inch-diameter pipe, minimum). The piping and appurtenances are sized to accommodate the 40 gpm design flow rate from PE-1. PG&E will also consider the use of extra piping at the site (e.g., 3-inch by 6-inch or 4-inch by 8-inch) to use existing materials that are onsite. The pipeline will be equipped with a leak detection sensor station at a low point (or 400-foot interval) in the line to detect any leaks in the inner conveyance pipe. The location of this sensor station can be adjusted in the field to avoid disturbing vegetation.

Piping inside the Well Vault #3 will be Schedule 80 chlorinated polyvinyl chloride. The design includes one 2.5-inch conduit for 460V/3-phase power supply and one 2-inch conduit for instrumentation. A third, spare 2-inch conduit may be installed between Well Vault #3 and Valve Vault #1 to accommodate future performance monitoring requirements, such as automating water level data collection from monitoring wells.

Drawing TP-PC-10-10-08 includes a typical trench detail for a single pipeline (see profile No. 6 on drawing) and a typical leak detection sensor station for the double-contained high-density polyethylene pipeline. The containment influent pipe, conduits for power and instrumentation, and leak detection sensor(s) will be constructed within a common trench across the floodplain. The nominal bottom width of the trench will be 24 inches wide and approximately 5 feet deep (on average) to accommodate the installations and maintain a minimum of 3 feet of cover. The sidewalls of the trench will be sloped per OSHA guidelines to allow workers to enter the trench.

It is important to note that future tie-ins to the double-contained piping between PE-1 to Valve Vault #1 are not recommended, primarily due to the logistics of draining and/or controlling leakage of the contents and uncertainties in future flow rates. Such tie-ins would also require the construction of additional valve vaults in the Colorado River floodplain. Given the uncertainty of additional extraction wells and conveyance piping in the Colorado River floodplain, it would be difficult to site additional valve vault(s) along the PE-1 alignment. The current IM No. 3 design plan includes provisions for an additional extraction well PE-2 located to the south of the MW-20 bench, if needed in the future. Valve Vault #1 is also designed to accommodate up to five extraction wells. Drawing TP-PI-20-02-02 depicts the current plan to tie-in PE-1 and future extraction wells into Valve Vault #1 on the MW-20 bench. Valve Vault #4 located near monitoring well MW-19 can accommodate pipelines from future extraction wells.

### 2.2.5 Instrumentation and Controls

Drawing TP-PR-10-10-03 includes a process and instrumentation diagram for extraction well PE-1. As shown in the drawing, extraction well PE-1 will be outfitted with the following instrumentation and controls:

- Water level indicator to monitor low water levels in the well to protect the pump.
- Pressure relief valve and pressure indicator inside the well vault to protect the pipe and allow operators to monitor pump performance.
- Pressure indicator, flow meter, and flow control valves inside Valve Vault #1 at the MW-20 bench.

A sample port for extraction well PE-1 will be available inside Valve Vault #1 for water quality sampling.

## 2.3 Construction Access and Work Limits

The staging area being considered for these activities is the north end of the MW-20 bench and would be approved by the agencies prior to its use. Construction materials will be stockpiled at the IM No. 3 treatment plant and/or the MW-20 bench and moved to the staging area as needed. Access to the floodplain would be from Park Moabi Road at the MW-35 cluster, similar to prior drilling and groundwater monitoring program access to the floodplain. The access route is noted on Drawing SK-TP-PE1-1.

Due to the nature of the fine sandy soils in the floodplain, it is anticipated that a 50-foot-wide minimum right-of-way will be required to accommodate the trench, temporary soil stockpile, and access for materials and equipment. Existing vegetation that is within the trench excavation area will be removed. It is assumed that the trench excavation may be up to 20 feet wide, assuming one-half to 1 or shallower trench side slopes. Excavated soil will be stockpiled to avoid disturbing vegetation to the extent possible to complete the work. Drawing SK-TP-PE1-1 shows the alignment in relation to site vegetation. A biological monitor will be onsite to monitor the construction activities in the floodplain.

The sequence of construction activities would be to grub the route and install and backfill the well vault. Trenching would be done in approximately 250-foot increments (between

vaults), with the piping and conduits being joined together in the trench. Installing components in the vault could be completed concurrently with pipeline installation.

Required equipment will include a track hoe for grubbing, excavation, and transport of construction materials, a front-end loader, a track-mounted fusion bonding machine, a water buffalo (trailer with water tank and pump for compaction of trench backfill), and four-wheel-drive Gators. Small gas-driven generators will be needed to install the vault components. Construction will be overseen by a construction superintendent. Construction staff will include equipment operators, pipe installers, electricians, and general laborers (10 to 15 workers).

## 3.0 Mitigation Measures

---

PG&E anticipates that the following mitigation measures will apply during construction of the conveying piping and power supply in the Colorado River floodplain from extraction well PE-1 to Valve Vault #1 on the MW-20 bench.

- An onsite biologist and cultural resources monitor will be present as appropriate during trenching activities.
- Minor vegetation removal will be required along the pipeline alignment. A biologist knowledgeable with southwestern flora and fauna will conduct a pre-construction survey and will be present during vegetation removal to identify native tree species. In the event native tree species cannot be avoided, those trees will be transplanted to a nearby location approved by the onsite biologist.
- All applicable measures described in the September 17, 2004 Action Memo authorizing IM No. 3 activities will be implemented.

## 4.0 Construction Schedule

---

The main elements of the construction schedule for conveyance piping and power supply in the Colorado River floodplain are as follows:

- DTSC and BLM approval of the design plan for the conveyance facilities from the new extraction well.
- Materials required to construct the pipeline will be ordered after DTSC and BLM approve the design plan. It is assumed that it may take up to 4 weeks to have all of the materials for the pipeline manufactured and delivered to the site. PG&E will also use any extra piping and materials still onsite from IM No. 3 construction to build the PE-1 pipeline.
- The BLM has indicated that drilling and construction activities in the Colorado River floodplain may be constrained by biological resource considerations (e.g., potential habitat for the Willow Flycatcher may occur within this project area). The breeding season for the Willow Flycatcher extends from the spring through the summer and early fall. Approval to begin construction is subject to consideration by federal representatives, specifically biological resource experts.

It is expected that the conveyance piping and power supply can be constructed, tested, and brought into service over a 4- to 5-week period once materials are delivered to the site and BLM approves construction in the Colorado River floodplain. Mobilization time may vary depending on whether the PE-1 construction is completed in conjunction with current IM No. 3 plant construction or is completed later.

## 5.0 Required Permits and Approvals

---

Table 2 provides a listing of permits and approvals that have been identified as applicable to the installation of the extraction well facilities on the BLM-managed land adjacent to the Colorado River, near the PG&E Topock Compressor Station. All applicable and necessary permits and approvals will be documented prior to moving construction equipment to the site.

**TABLE 2**  
Permits, Approvals, and Certifications for Extraction Wells  
*PG&E Topock Compressor Station, Needles, California*

Agency	Permits, Approvals, Certifications, etc.
BLM	BLM issued Action Memorandum authorizing IM activities on BLM land. BLM field office review and approval pending.
DTSC	DTSC is evaluating DTSC's responsibilities under California Environmental Quality Act as they relate to this project.
State Water Resources Control Board/ Colorado River Basin Regional Water Quality Control Board	Notice of Intent and Storm Water Pollution Prevention Plan for construction activities; coverage under statewide general permit.
United States Fish and Wildlife Service (USFWS)	Informal Consultation by BLM with USFWS. Project activities shall avoid potential impacts to sensitive species.
California Department of Fish and Game (CDFG)	CDFG 1600 (emergency exemption)
State Historic Preservation Office	Section 106 Consultation
San Bernardino County	San Bernardino County issued well permit. No other permits pending. Site inspections will proceed consistent with current IM No. 3 construction.

## 6.0 References

---


- CH2M HILL. 2004a. *Cultural Resources Investigations for Interim Measures No. 3: Topock Compressor Station, Expanded Groundwater Extraction and Treatment System*. August.
- \_\_\_\_\_. 2004b. *Thirty Percent Design Submittal, Interim Measures No. 3, PG&E, Topock Compressor Station, Needles, California*. September 16.
- \_\_\_\_\_. 2005a. *Extraction Well Work Plan, PG&E Topock Compressor Station, Needles, California*. February 23.
- \_\_\_\_\_. 2005b. *Groundwater Extraction Well, PE-1 Installation Report, PG&E Topock Compressor Station, Needles, California*. April 29.
- Department of Toxic Substances Control (DTSC). 2004. Letter to Yvonne Meeks/PG&E from Norman Shopay/DTSC. September 21.
- \_\_\_\_\_. 2005a. Letter to Yvonne Meeks/PG&E, from Norman Shopay/DTSC. February 16.
- \_\_\_\_\_. 2005b. Letter to Yvonne Meeks/PG&E, from Norman Shopay/DTSC. February 25.
- United States Bureau of Land Management (BLM). 2004. *Time Critical Removal Action, Pacific Gas and Electric Topock Compressor Facility*. March 3.
- \_\_\_\_\_. 2005. Letter to Yvonne Meeks/PG&E, from Robert Henderson/BLM. February 25.



## **Appendix A**

### **Drawings for PE-1**

---

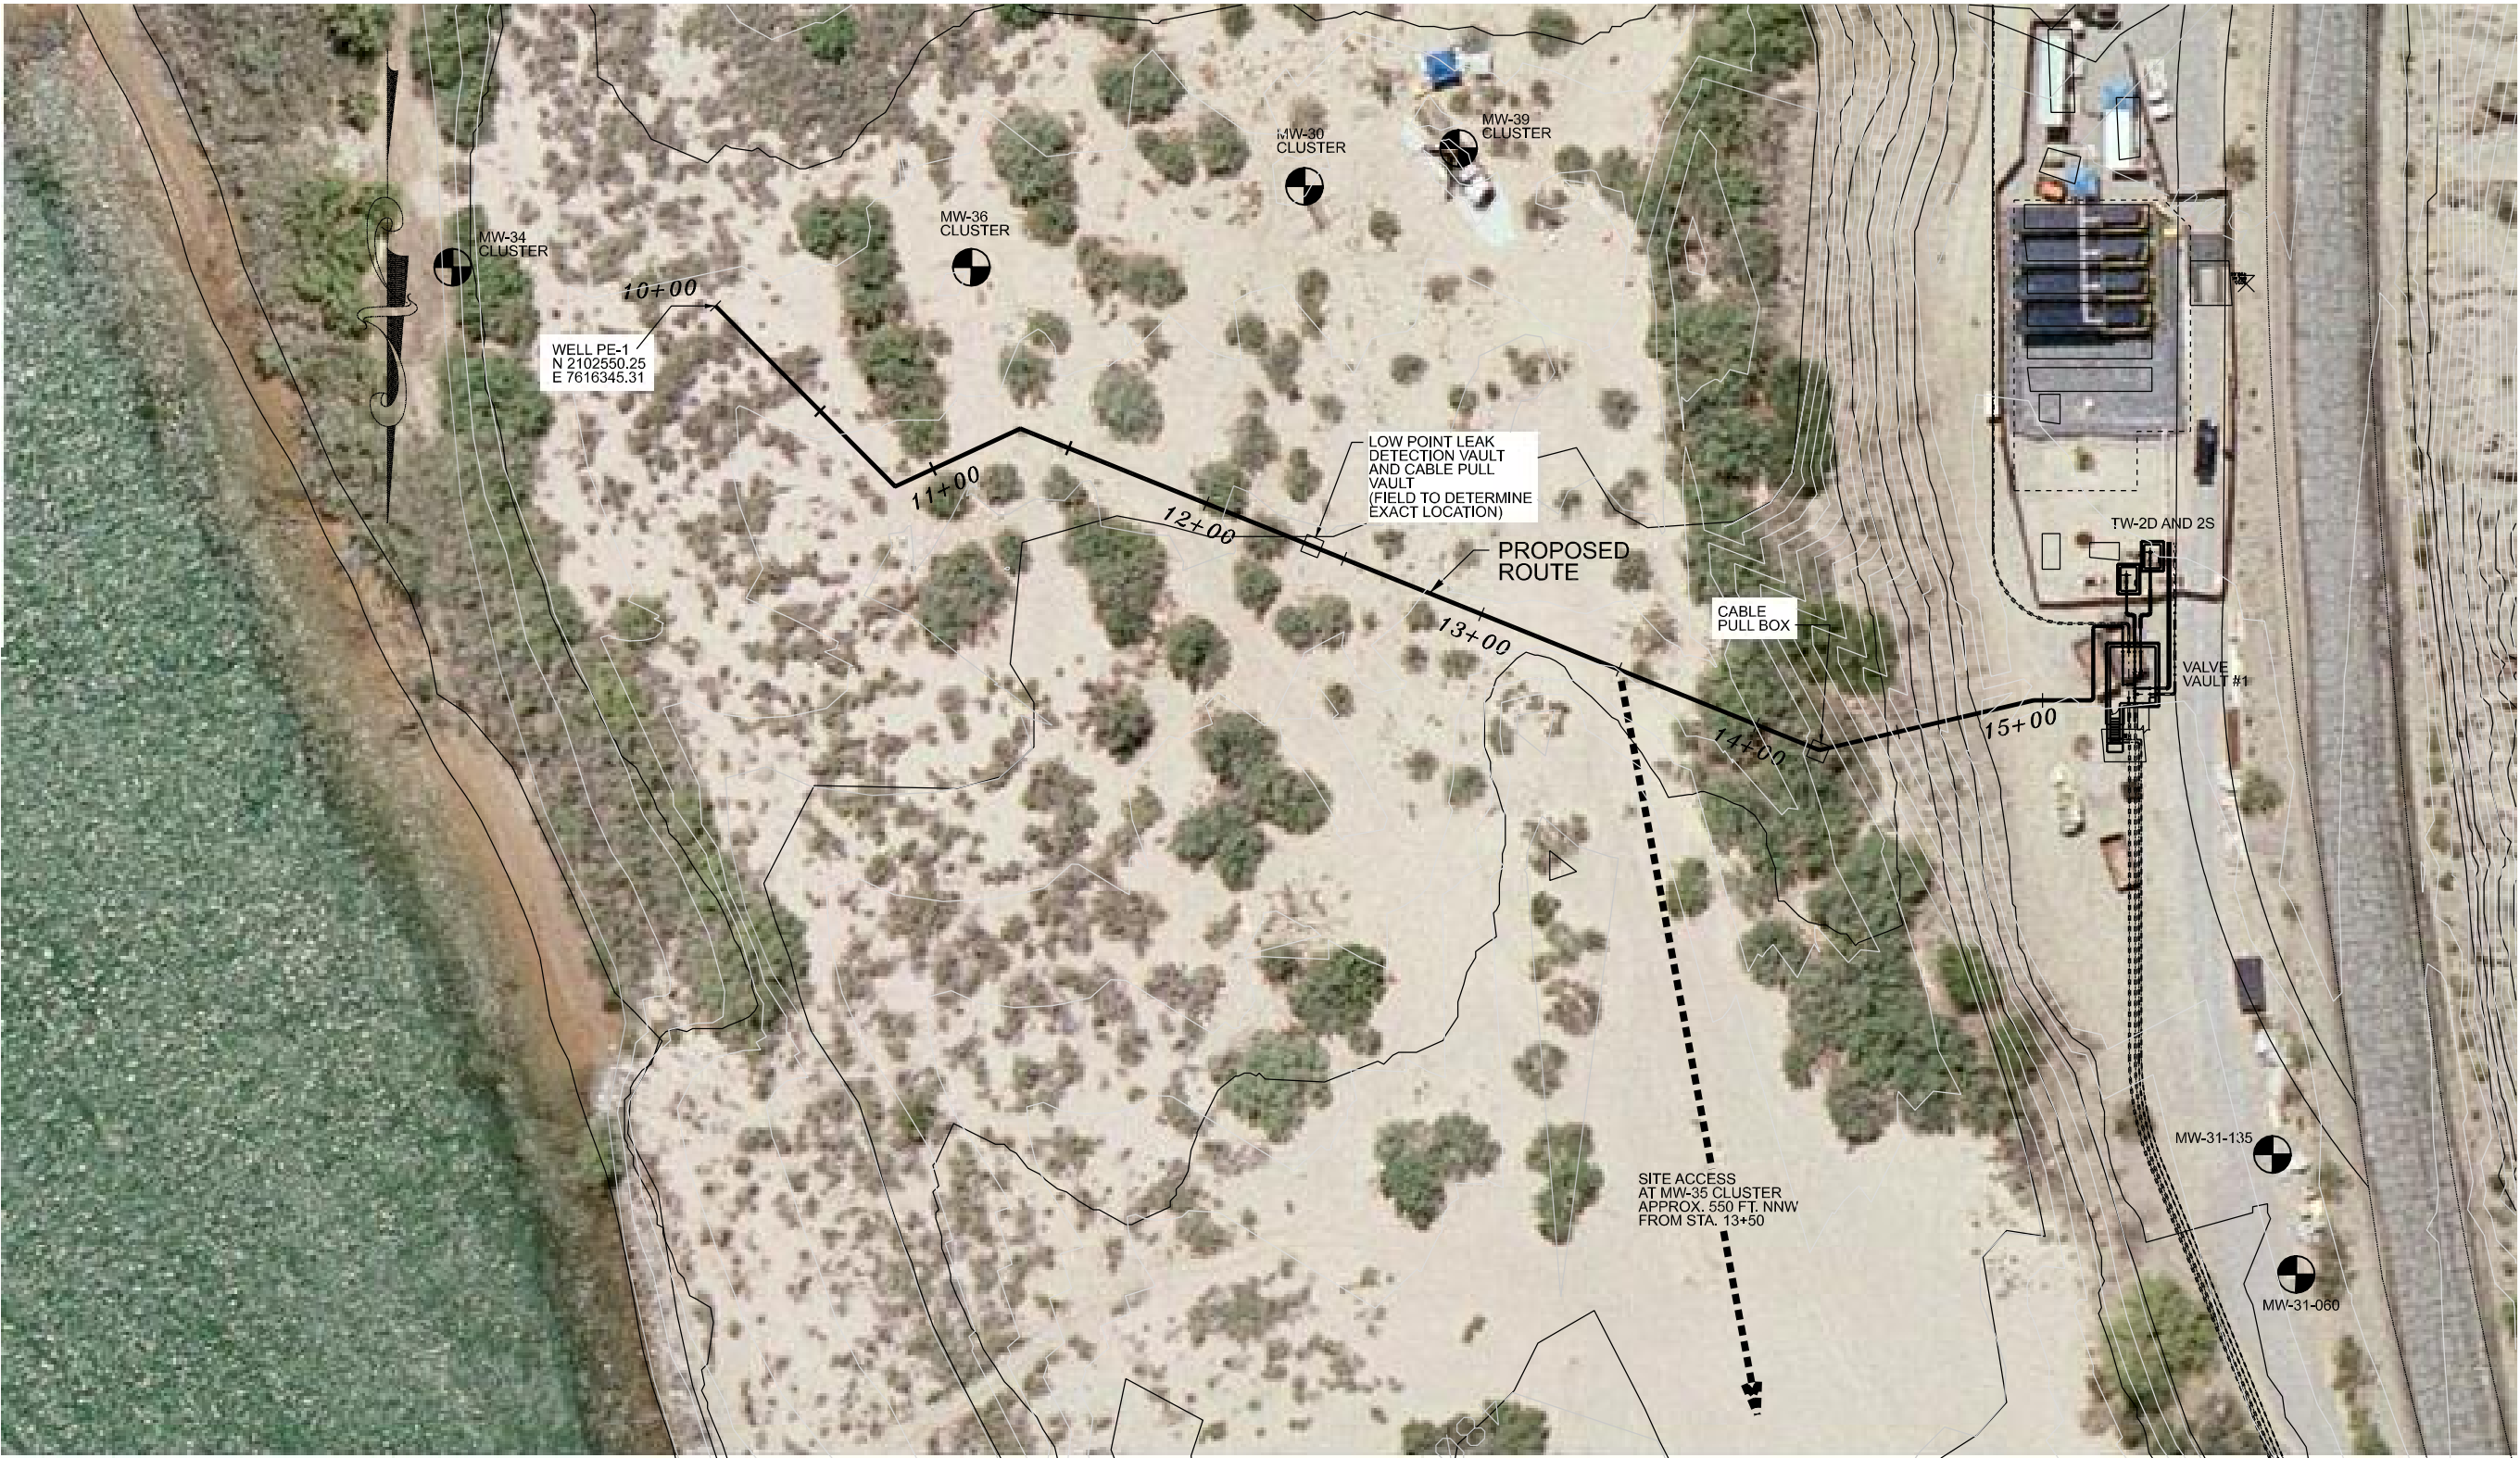

RESPONSIBLE ENGINEER	NO.	DATE	REVISION	BY	CHK	REVISION APPROVAL		REV B	DATE 07/28/05	PRINT DISTRIBUTION	STATUS				
	B	07/26/05	REVISED ROUTE PER COMMENTS	EFC	SDH	DISCIPLINE	REVIEWED	DISCIPLINE	REVIEWED	DATE	ISSUED	REV	DATE	SDE	PEM
	A	05/17/05	Conceptual layout for review and comment	JBW	SDH	CIVIL		ELECTRICAL		STATUS	PRELIMINARY		/ /		
						STRUCTURAL		INST & CONTROL		REV.	FOR REVIEW AND APPROVAL	B	07/26/05		
						MECHANICAL		ARCHITECTURAL		CLIENT	APPROVED FOR CONSTRUCTION		/ /		
						PROCESS		ENVIRONMENTAL		FIELD	REVISED & APPROVED FOR CONSTRUCTION		/ /		
						PIPING		GEN. ARRANG.		INTRA CD.					

SCALE 1"=30'

PACIFIC GAS & ELECTRIC  
TOPOCK COMPRESSOR STATION  
INTERIM MEASURE 3  
EXPANDED GROUNDWATER  
EXTRACTION AND TREATMENT  
SYSTEM



PROJECT NO. 327061

**CH2MHILL**

PIPING  
PLAN VIEW  
PROPOSED PE-1  
PIPELINE ROUTE

DWG. NO. SK-TP-PE1-1







REV. B

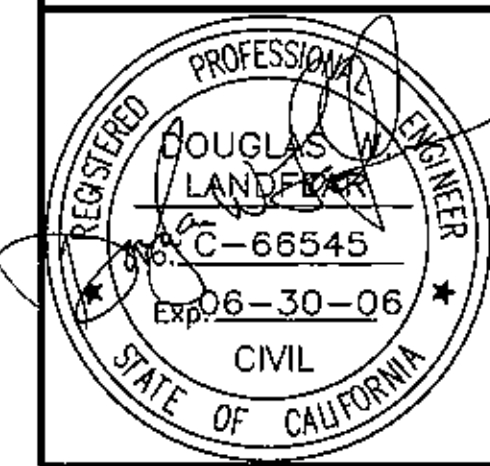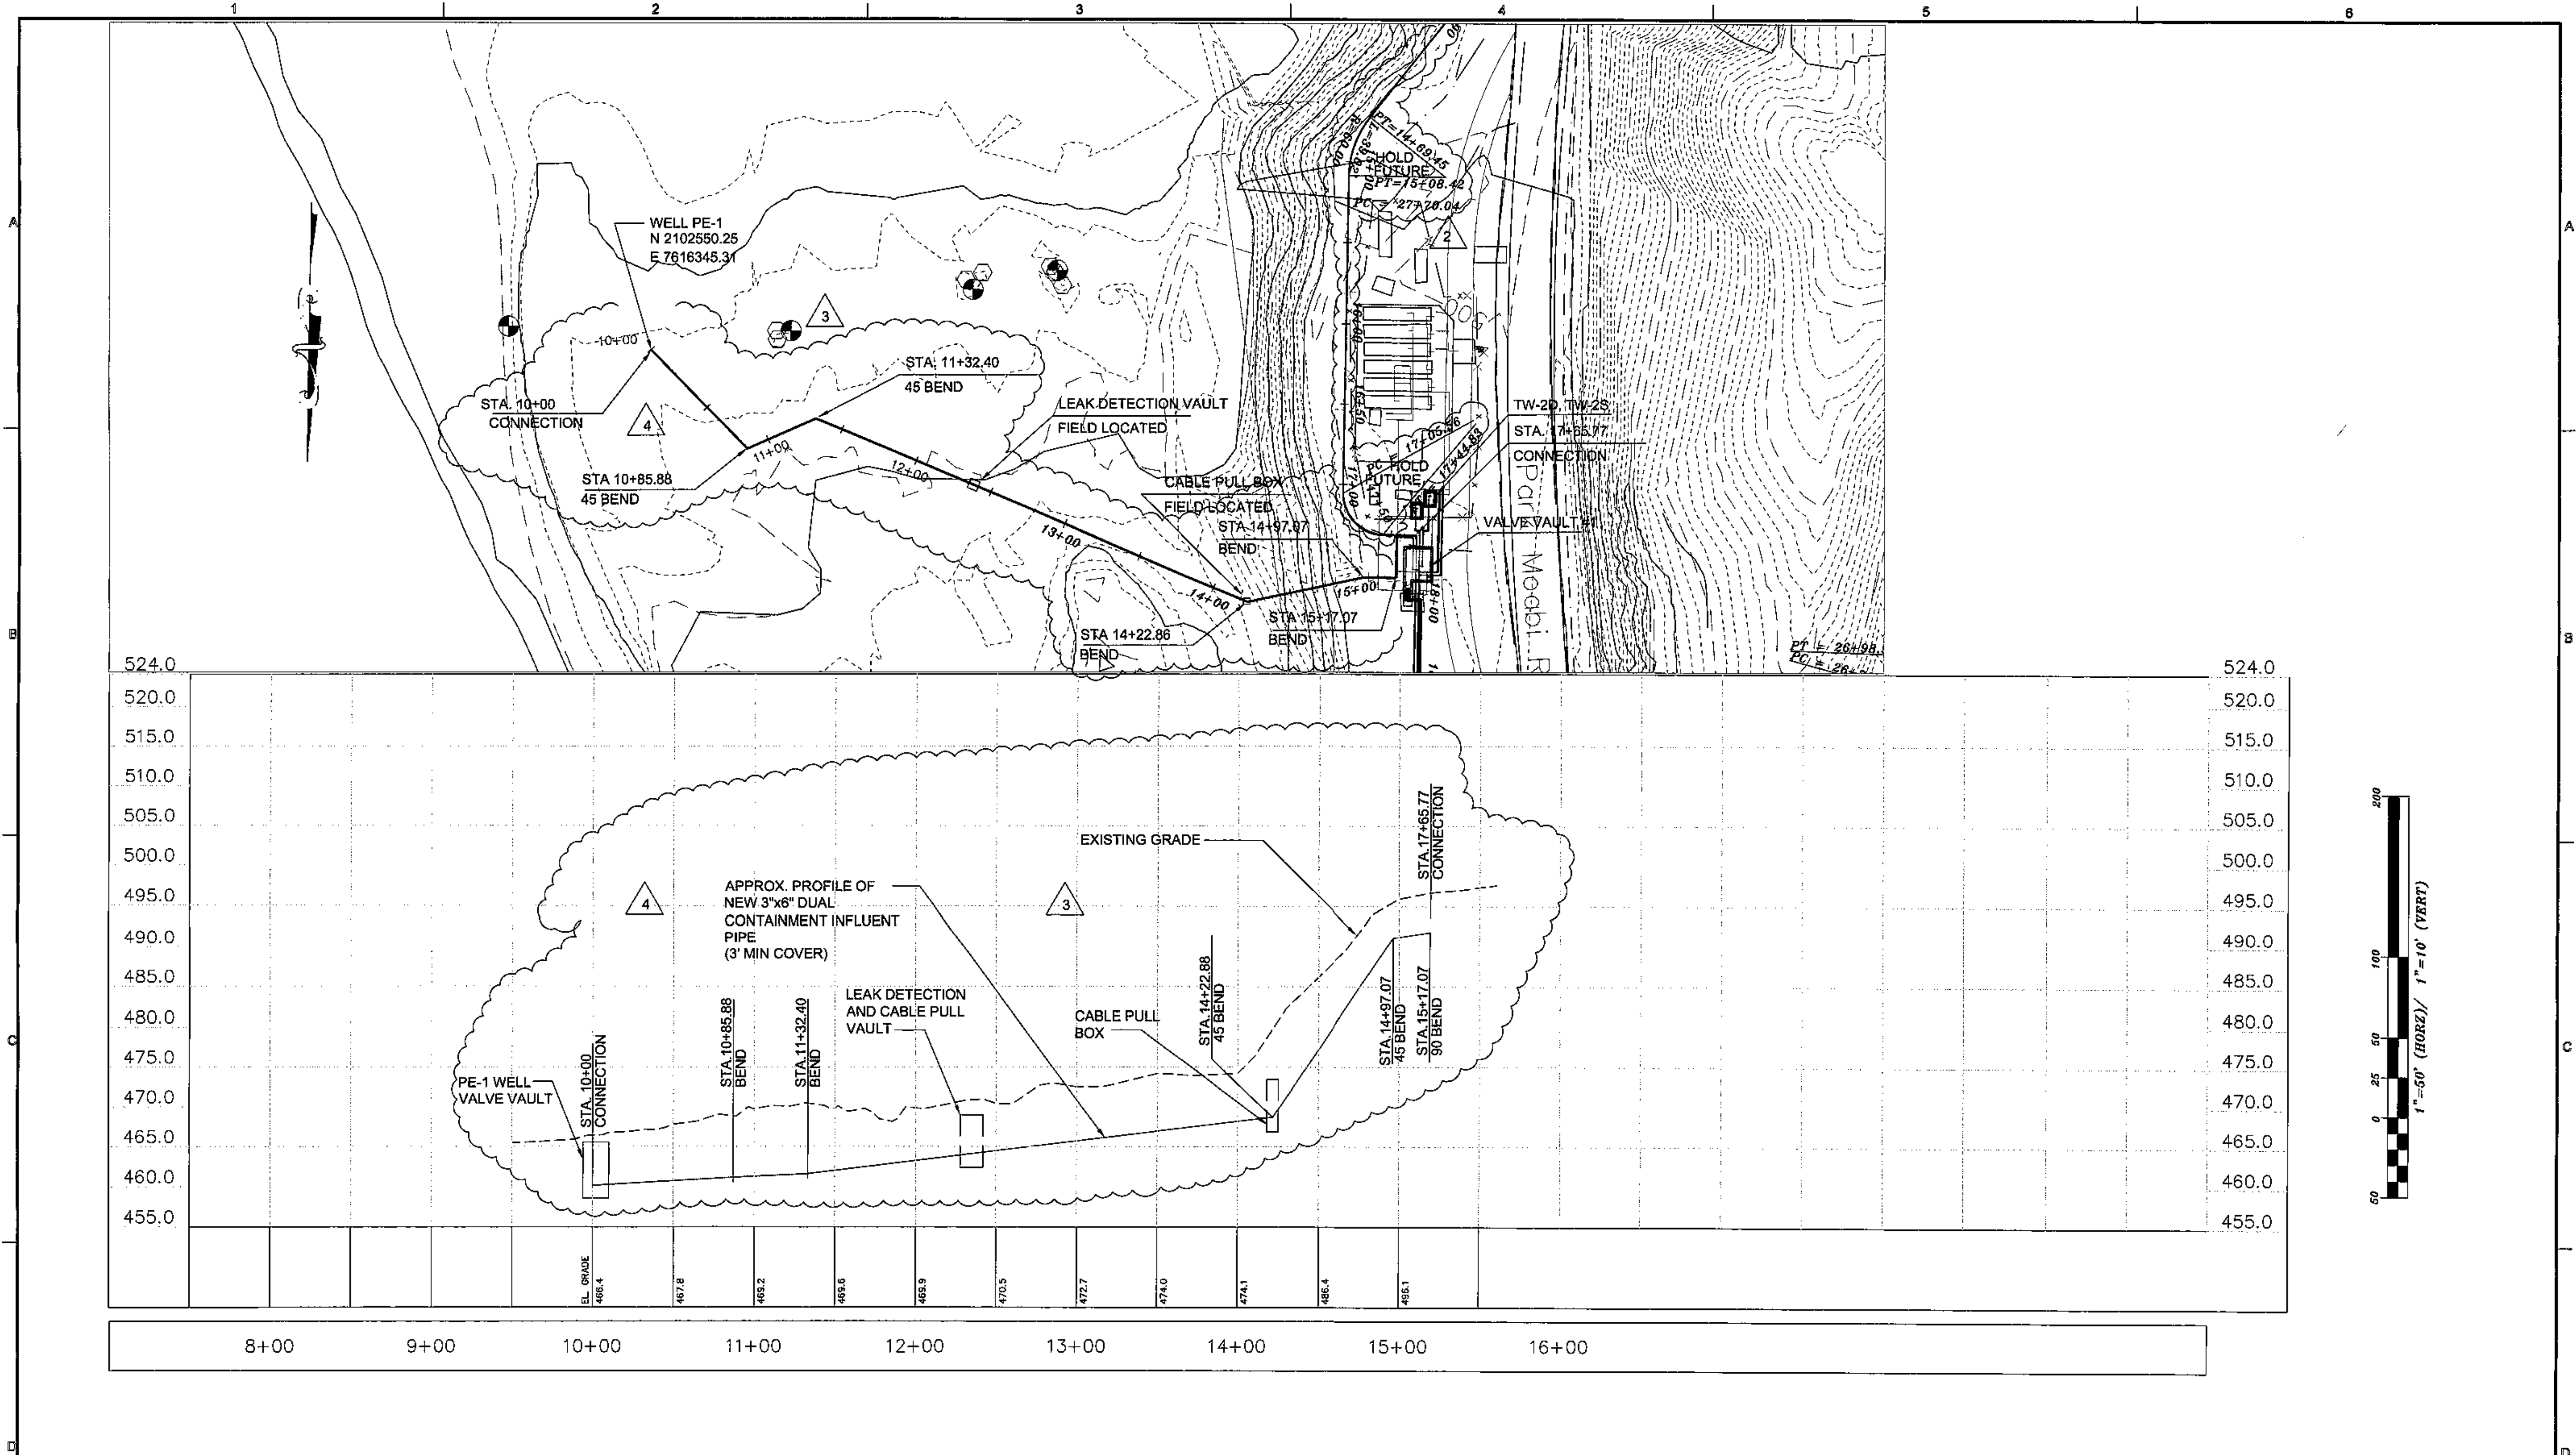


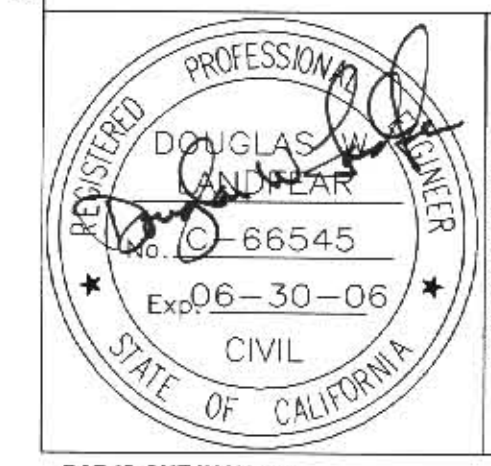
NO.	DATE	REVISION	BY	CHK	REVISION APPROVAL		REV 4	DATE 07/26/05	PRINT DISTRIBUTION	STATUS				
					DISCIPLINE	REVIEWED				ISSUED	REV	DATE	SDE	PEM
0	8/04	APPROVED FOR CONSTRUCTION	ABH	DWL						PRELIMINARY				
1	9/04	REVISED AS NOTED	ABH	DWL	CIVIL		ELECTRICAL			FOR REVIEW AND APPROVAL	A	7/28/04	DWL	
2	11/04	REVISED AS NOTED	ABH	DWL	STRUCTURAL		INST & CONTROL			APPROVED FOR CONSTRUCTION	0	8/06/04	DWL	
3	03/05	REVISED ALIGNMENT	WHD	DWL	MECHANICAL		ARCHITECTURAL			REVISED & APPROVED FOR CONSTRUCTION	4			
4	07/05	REVISED ALIGNMENT	EFC		PROCESS		ENVIRONMENTAL							
					PIPING		GEN. ARRANG.		INTRA CO.					

PACIFIC GAS & ELECTRIC CO. TOPOCK COMPRESSOR STATION INTERIM MEASURE 3 EXPANDED GROUNDWATER EXTRACTION AND TREATMENT SYSTEM		PIPING PLAN & PROFILE INFLUENT PIPELINE STA. 10+00 TO 15+00	
PROJ NO. 315994		DWG. NO. TP-PC-10-01-07	
SCALE AS SHOWN		REV. 4	



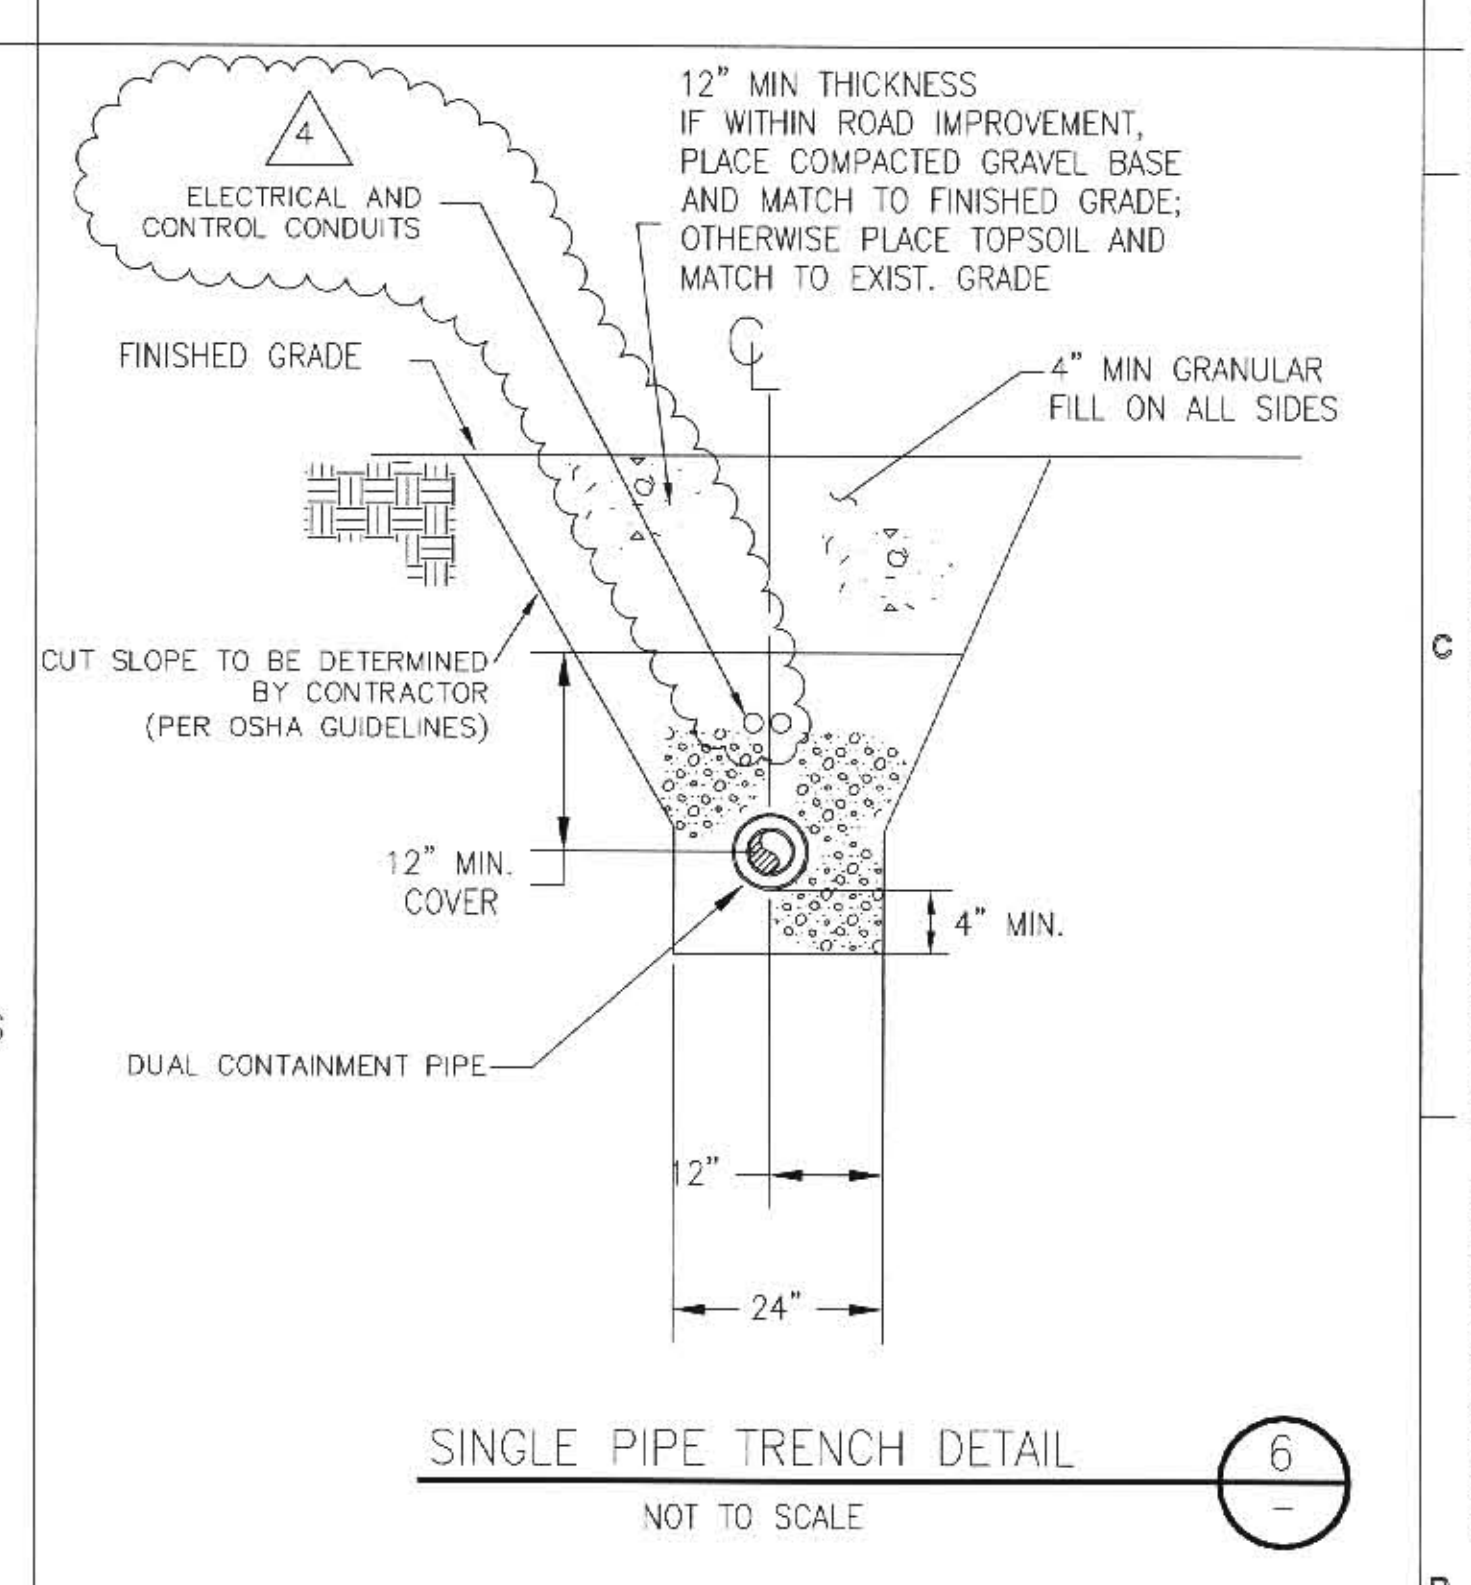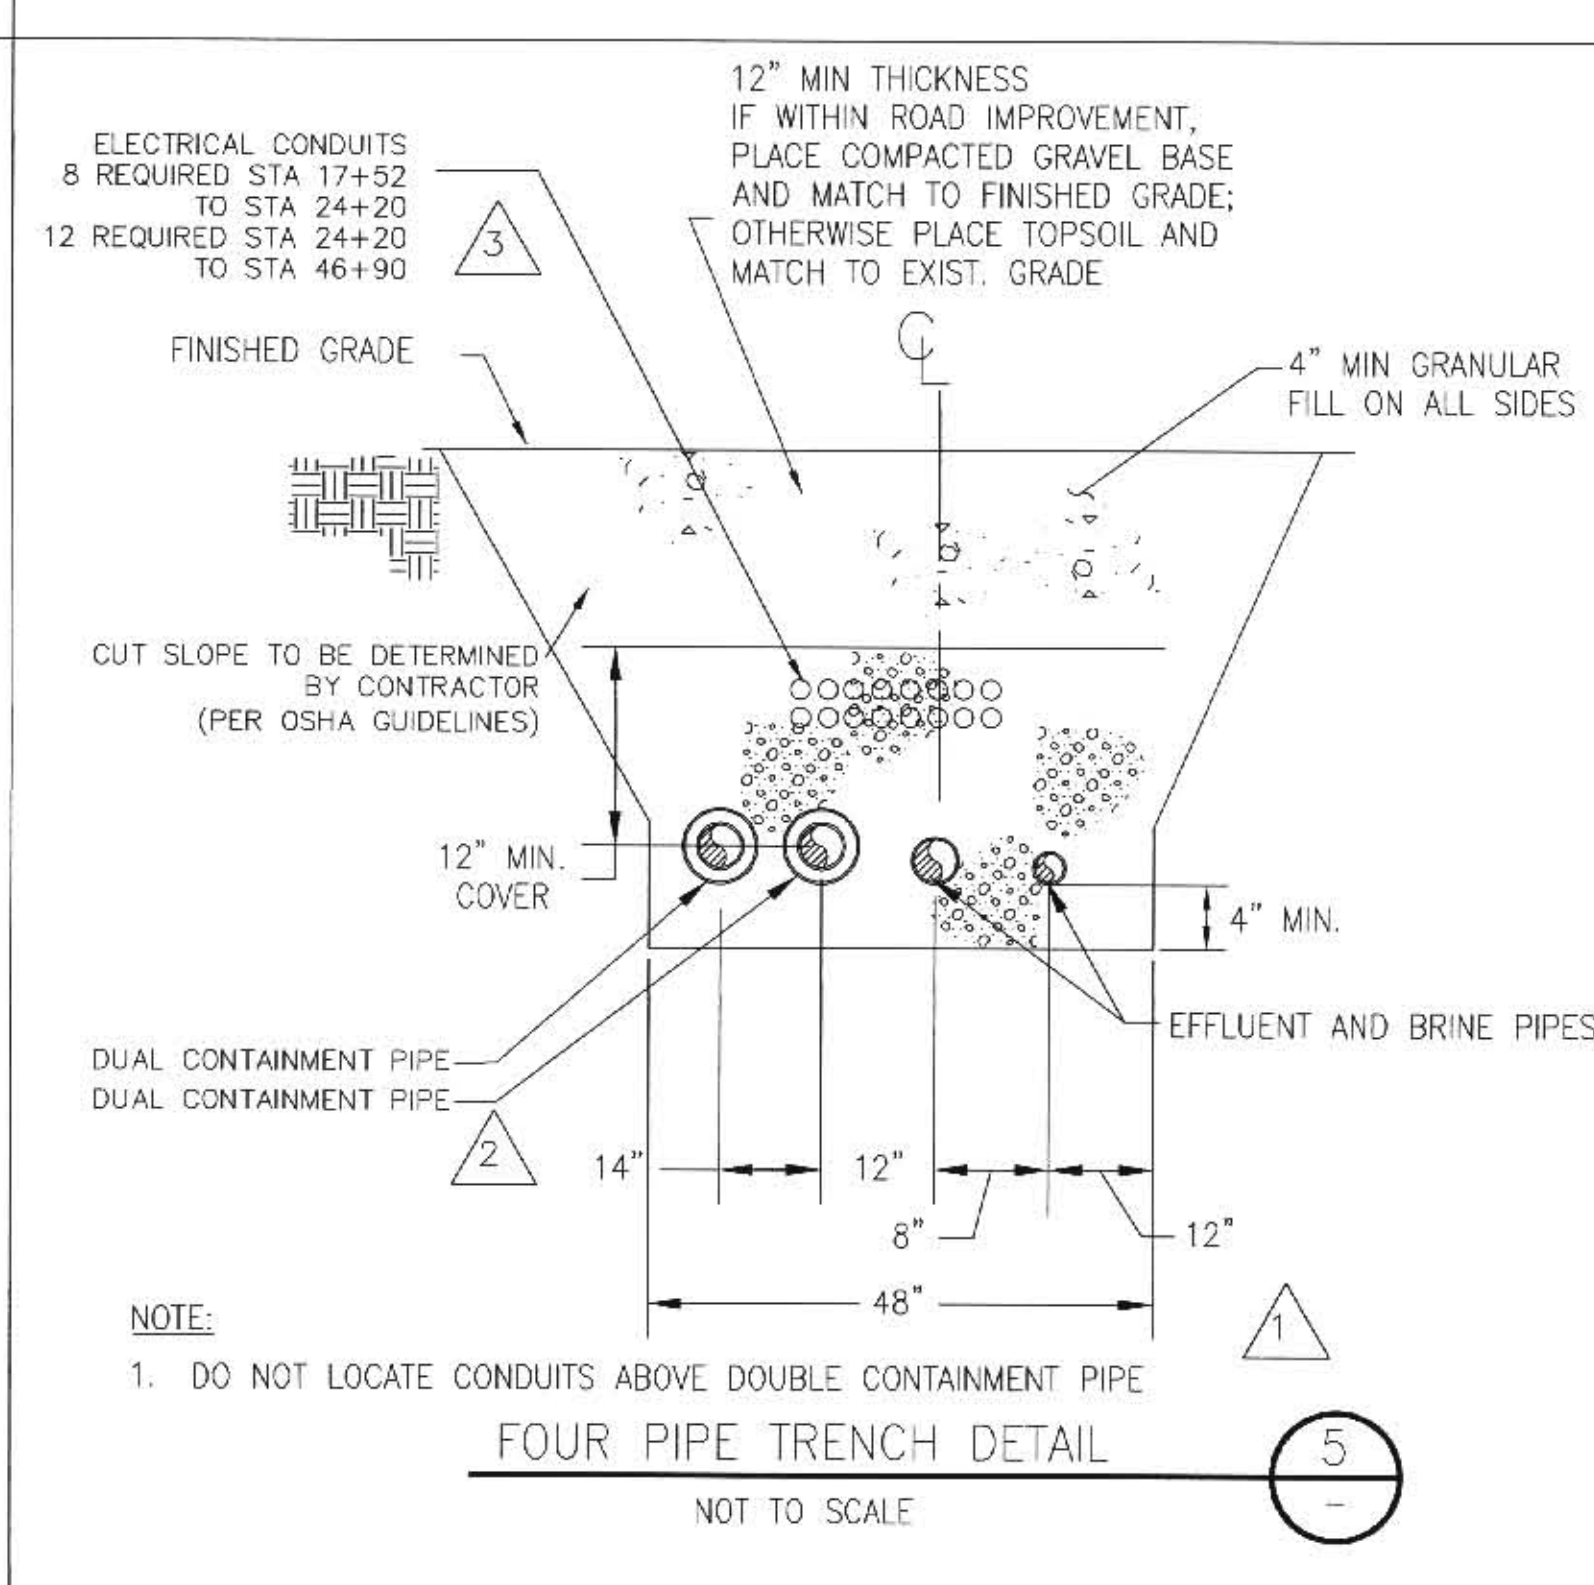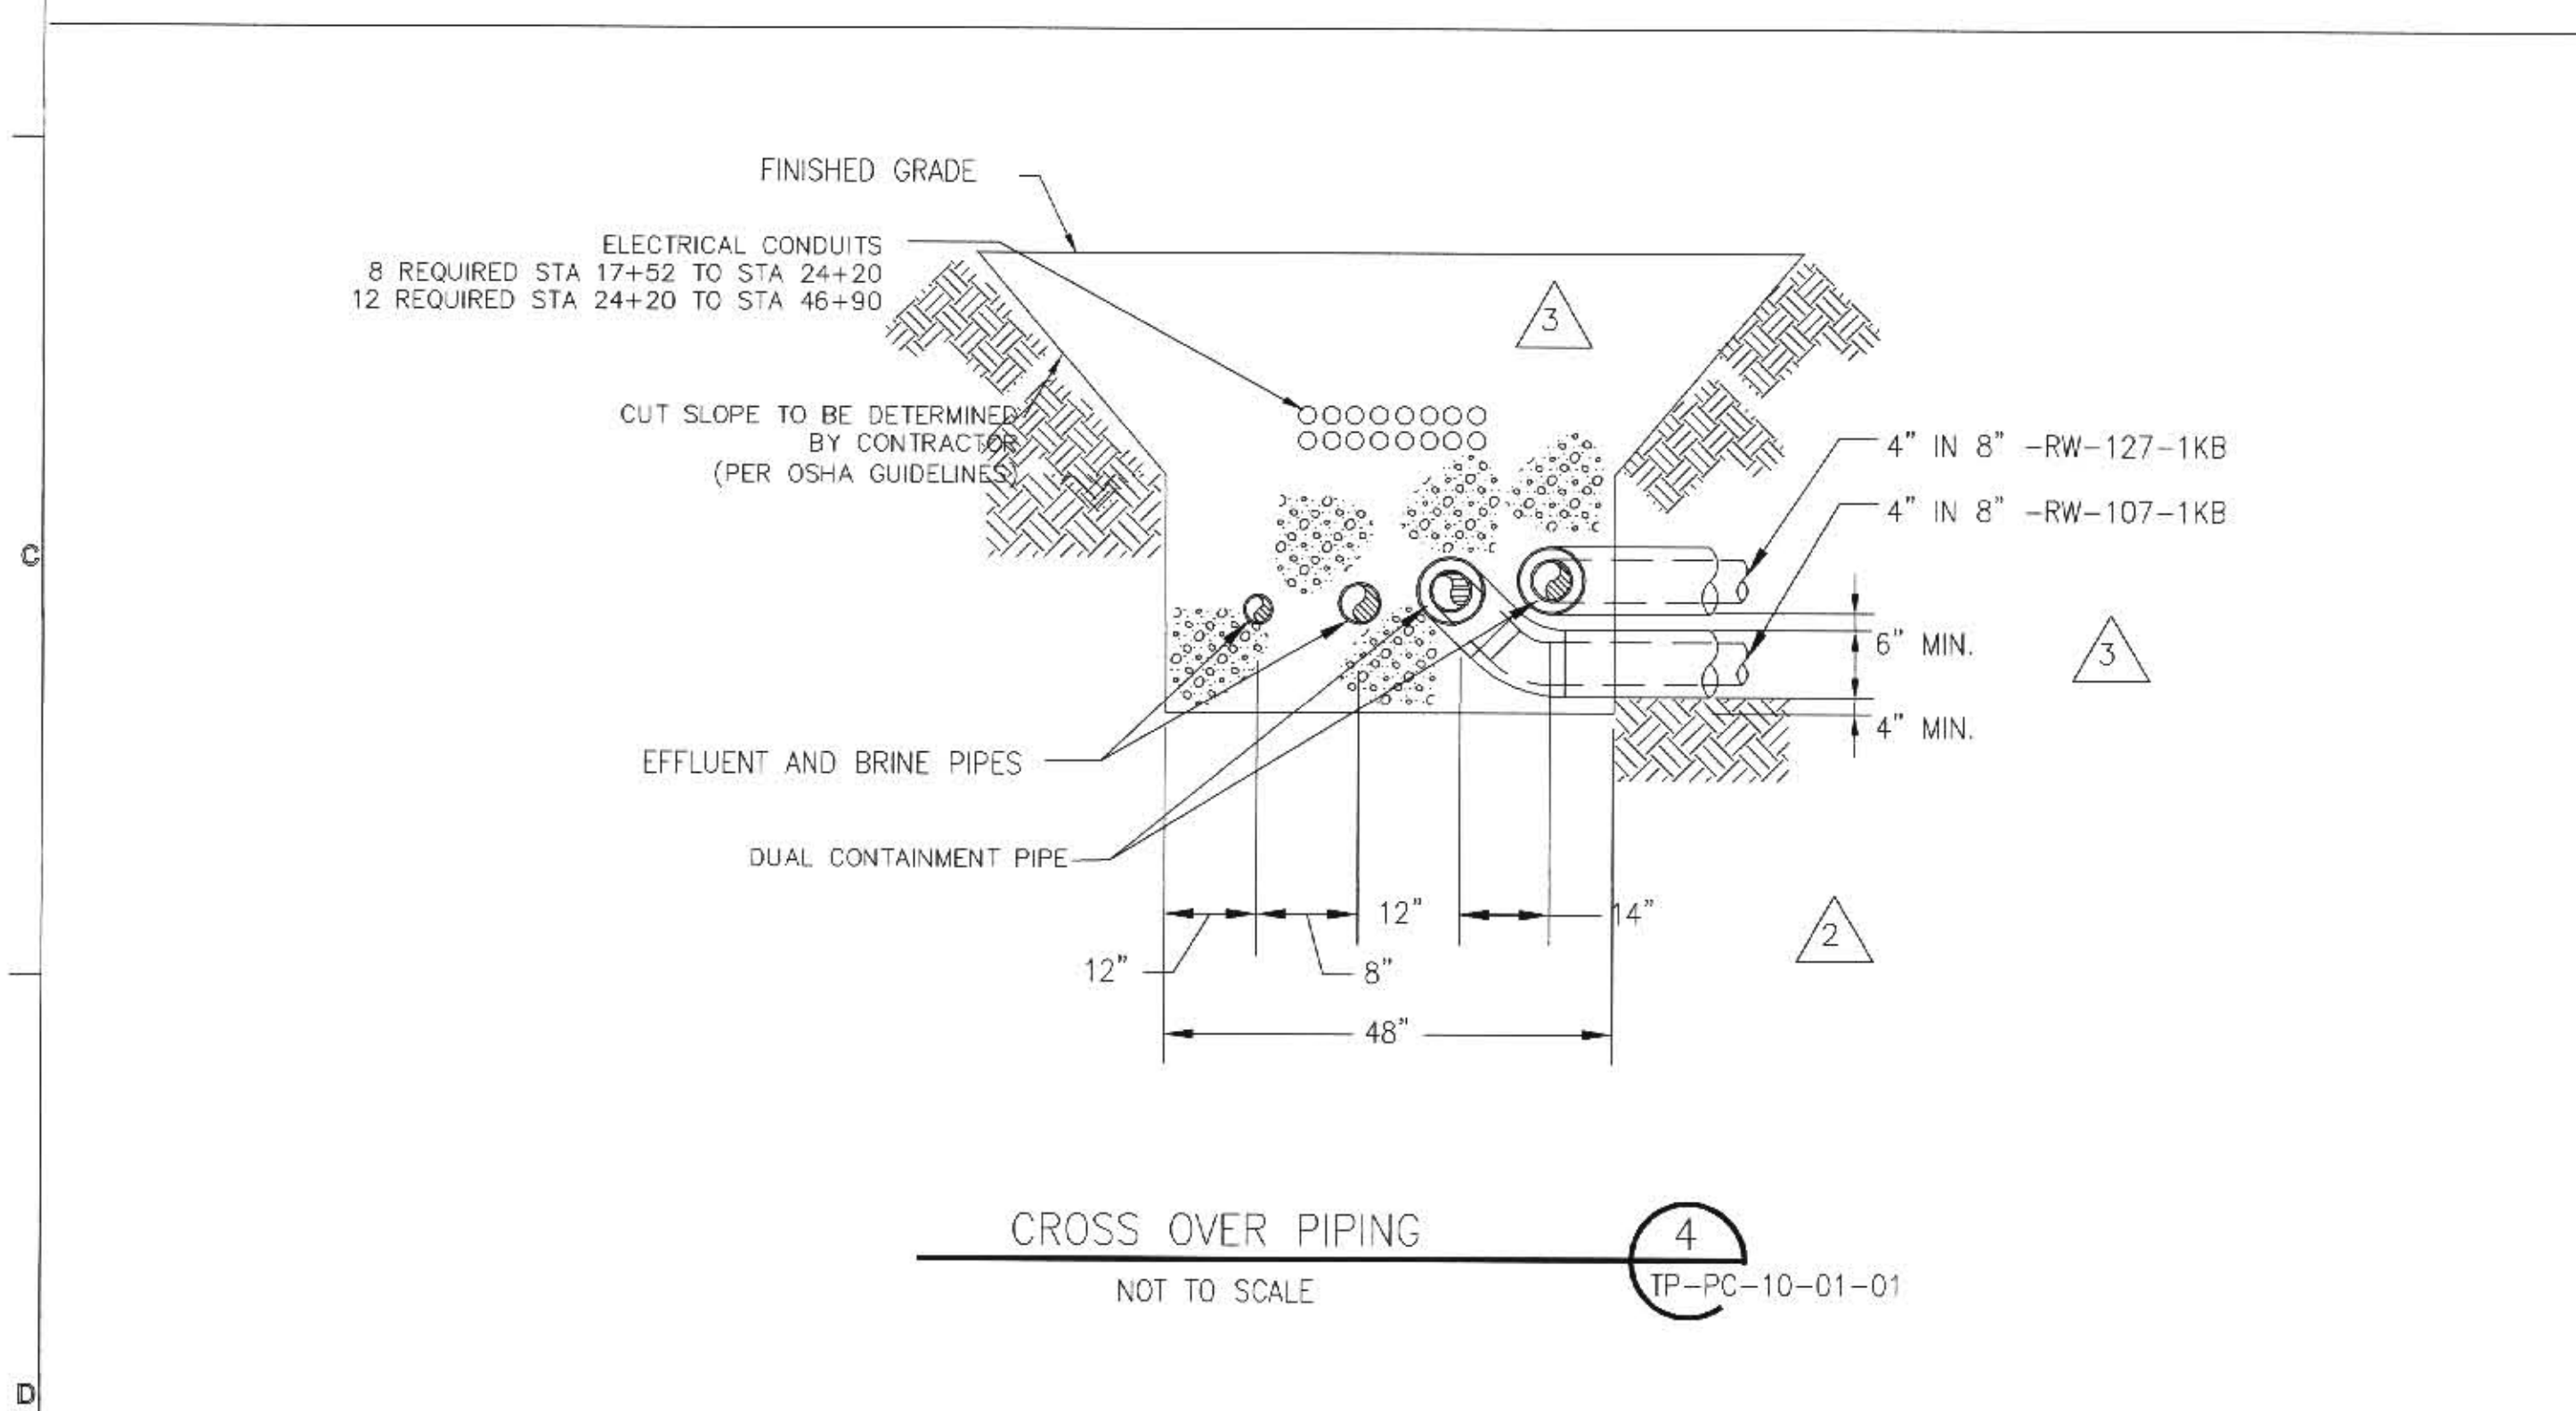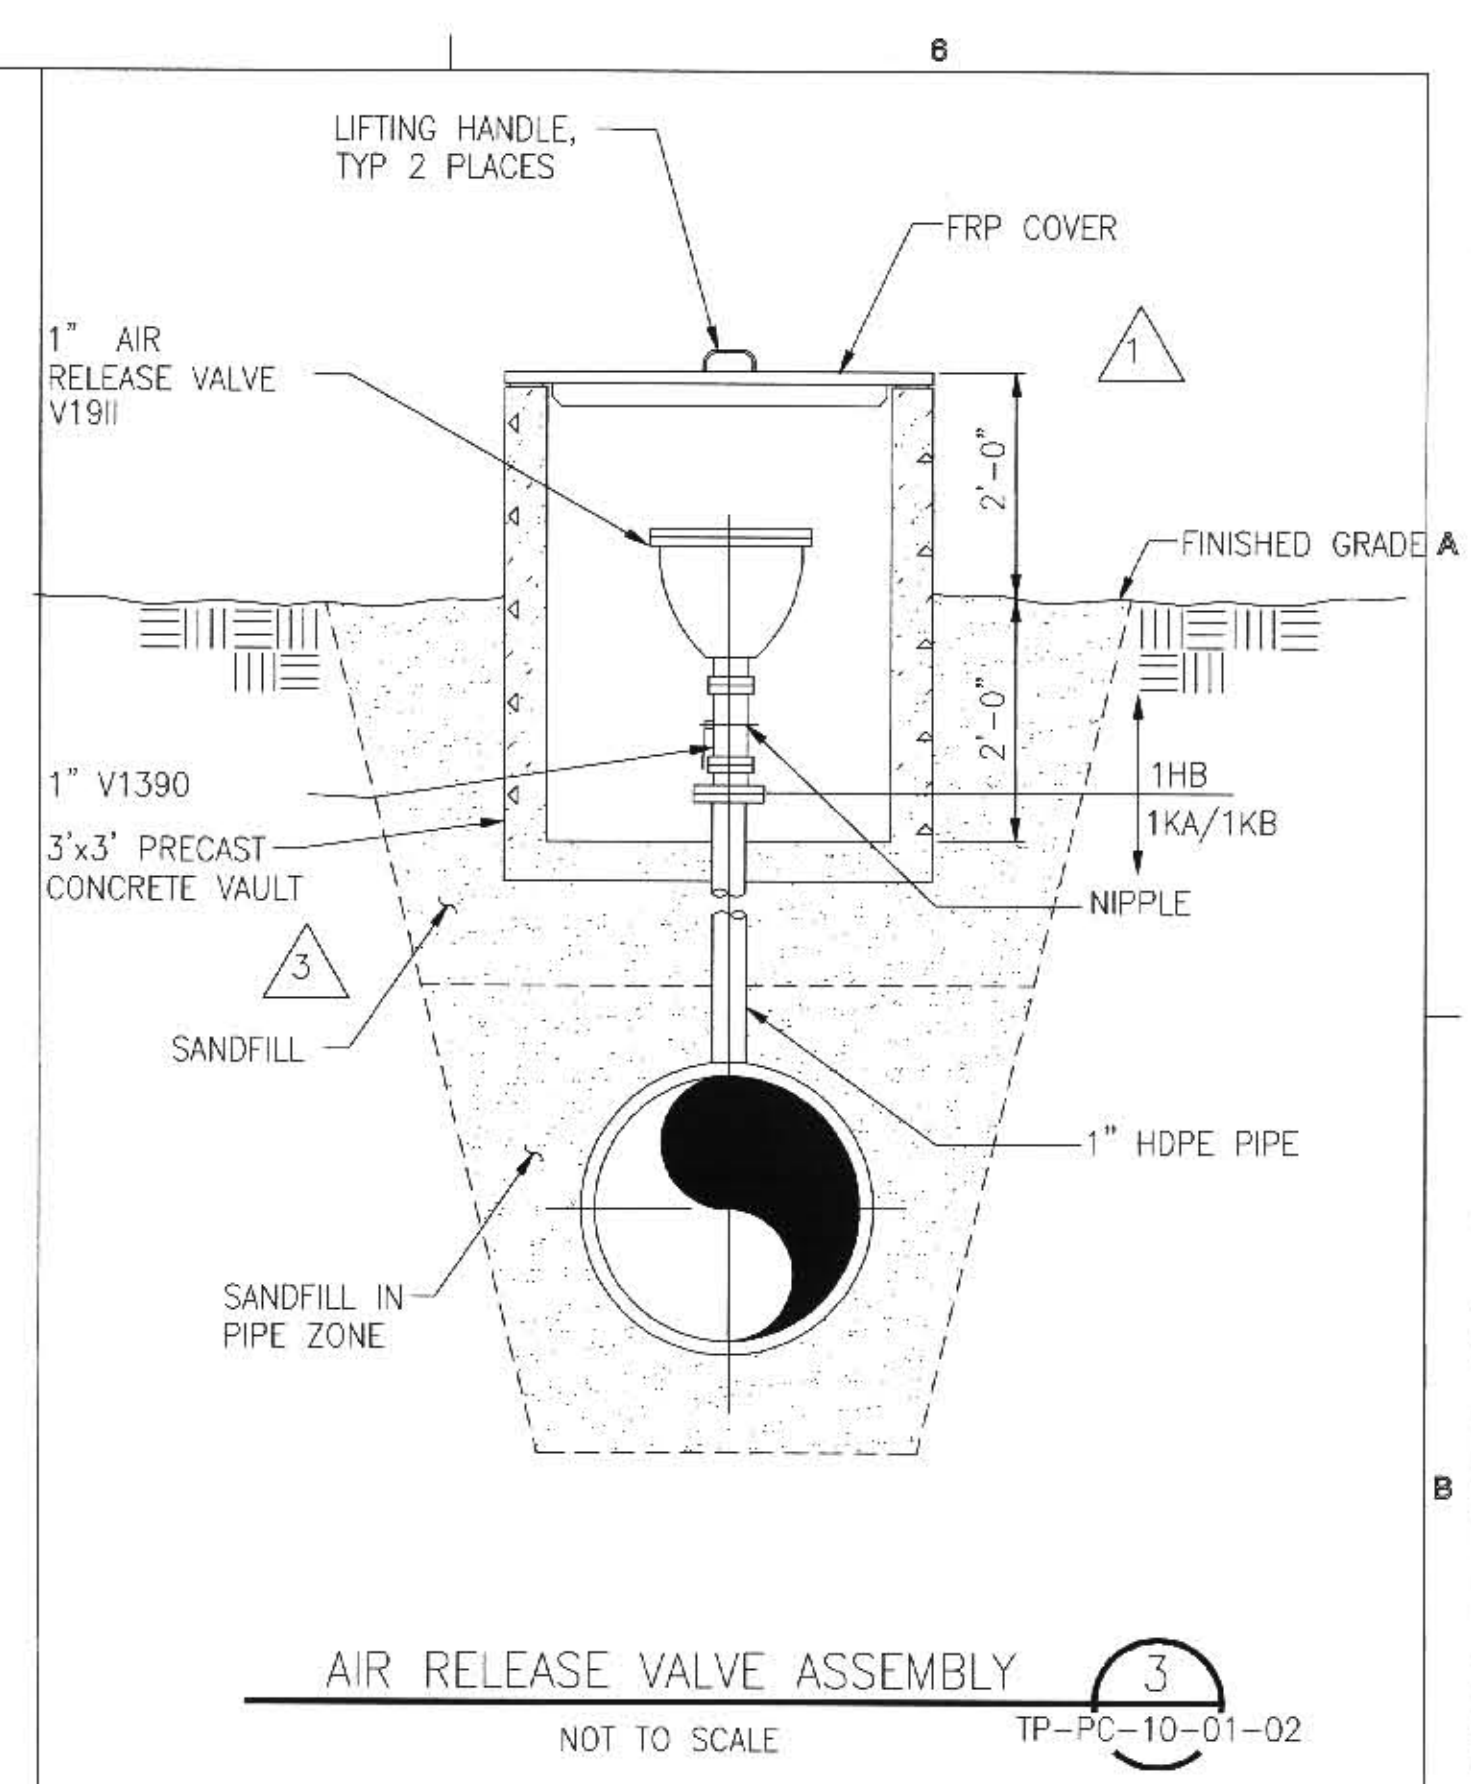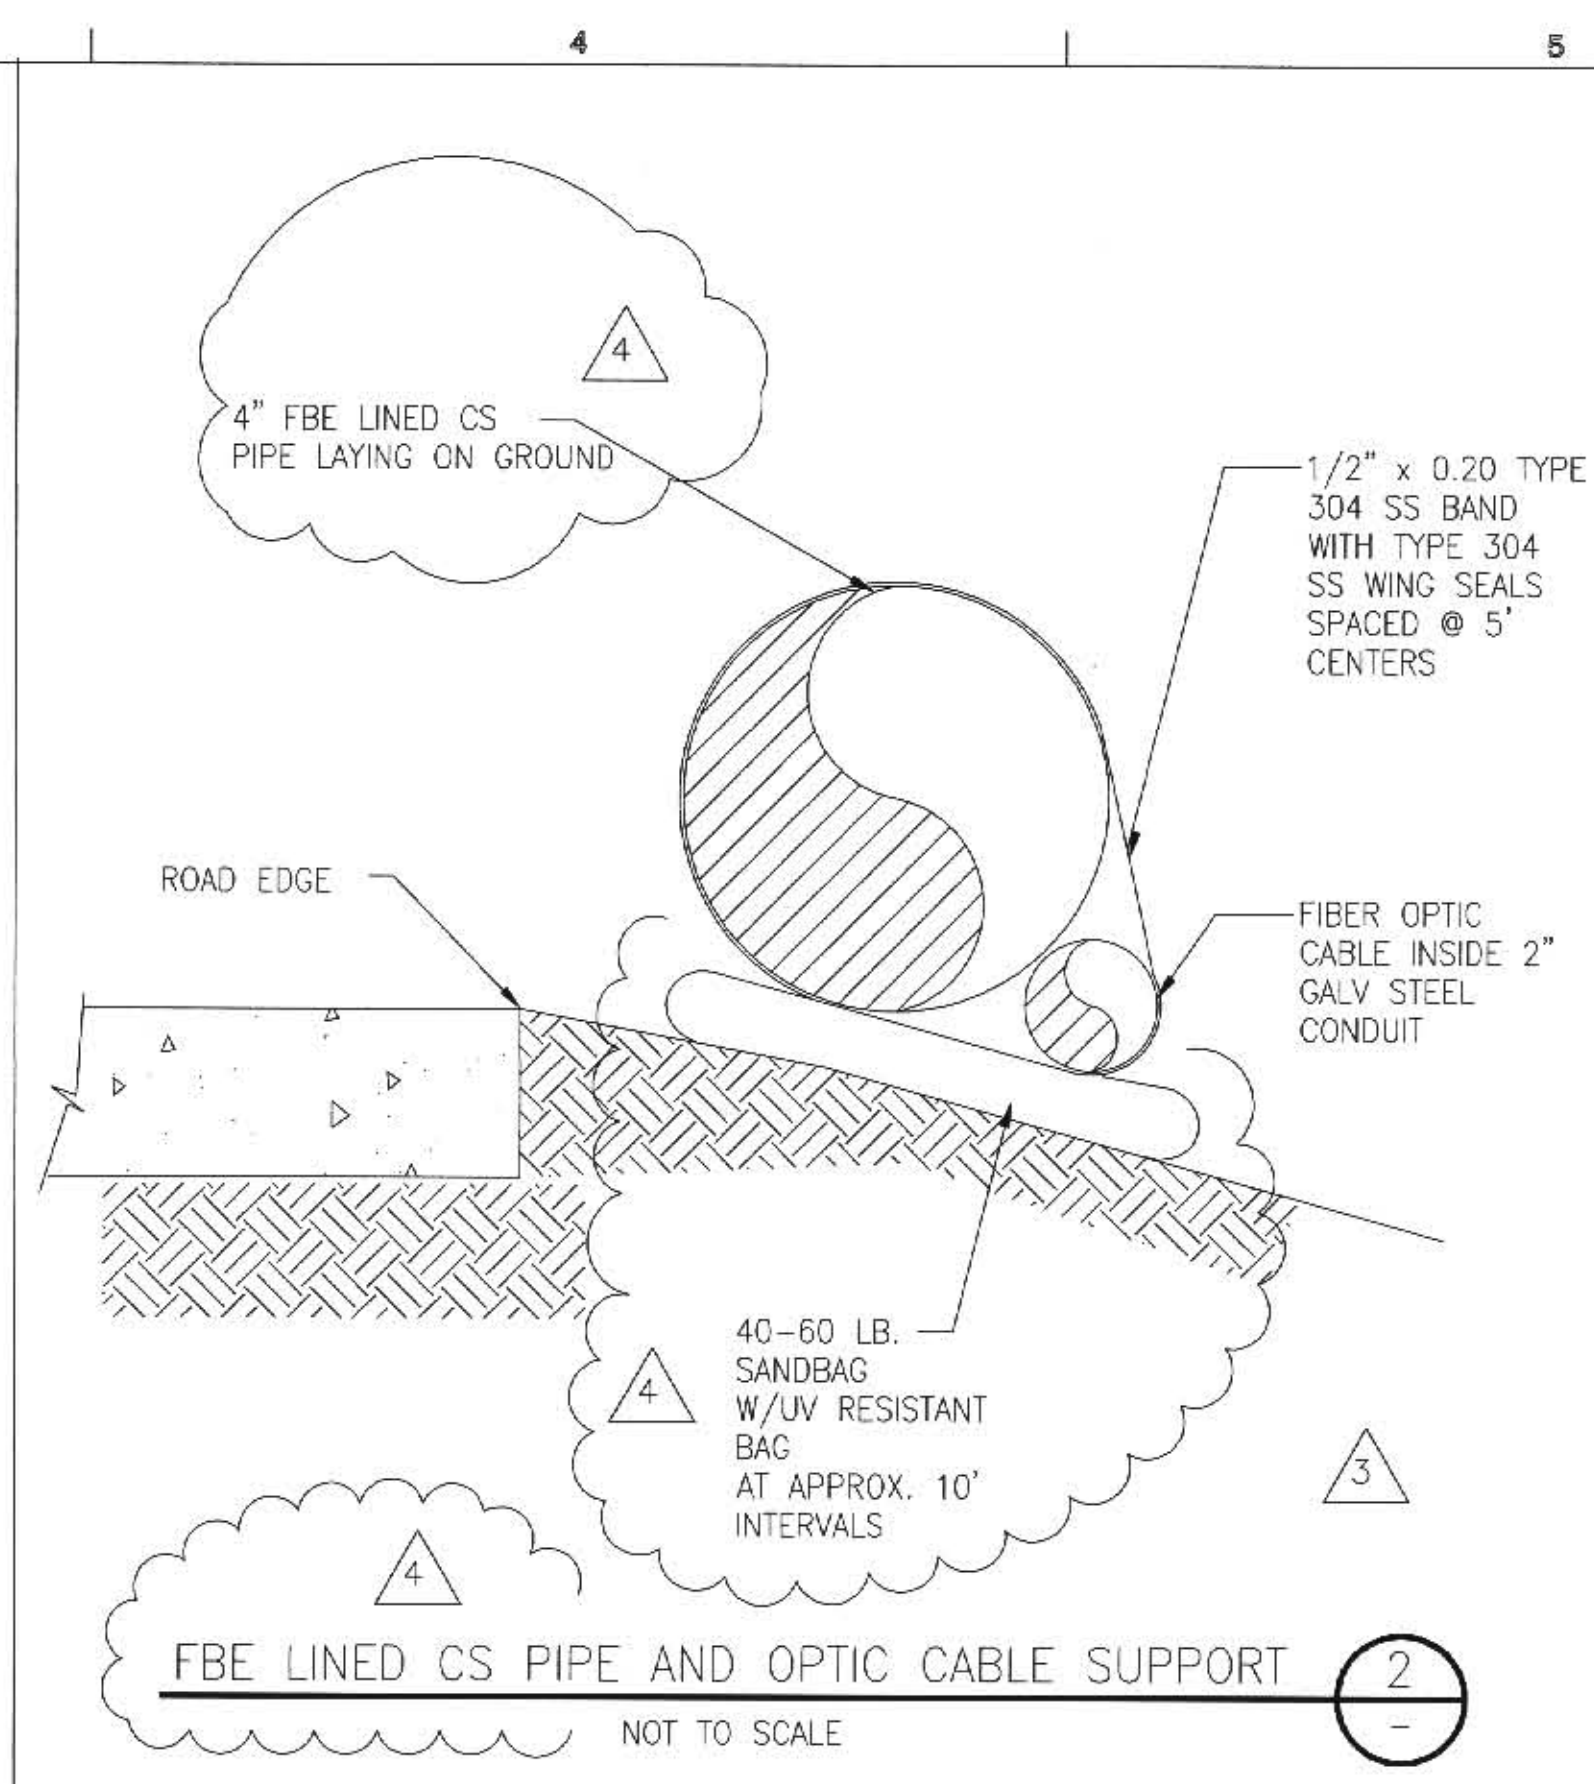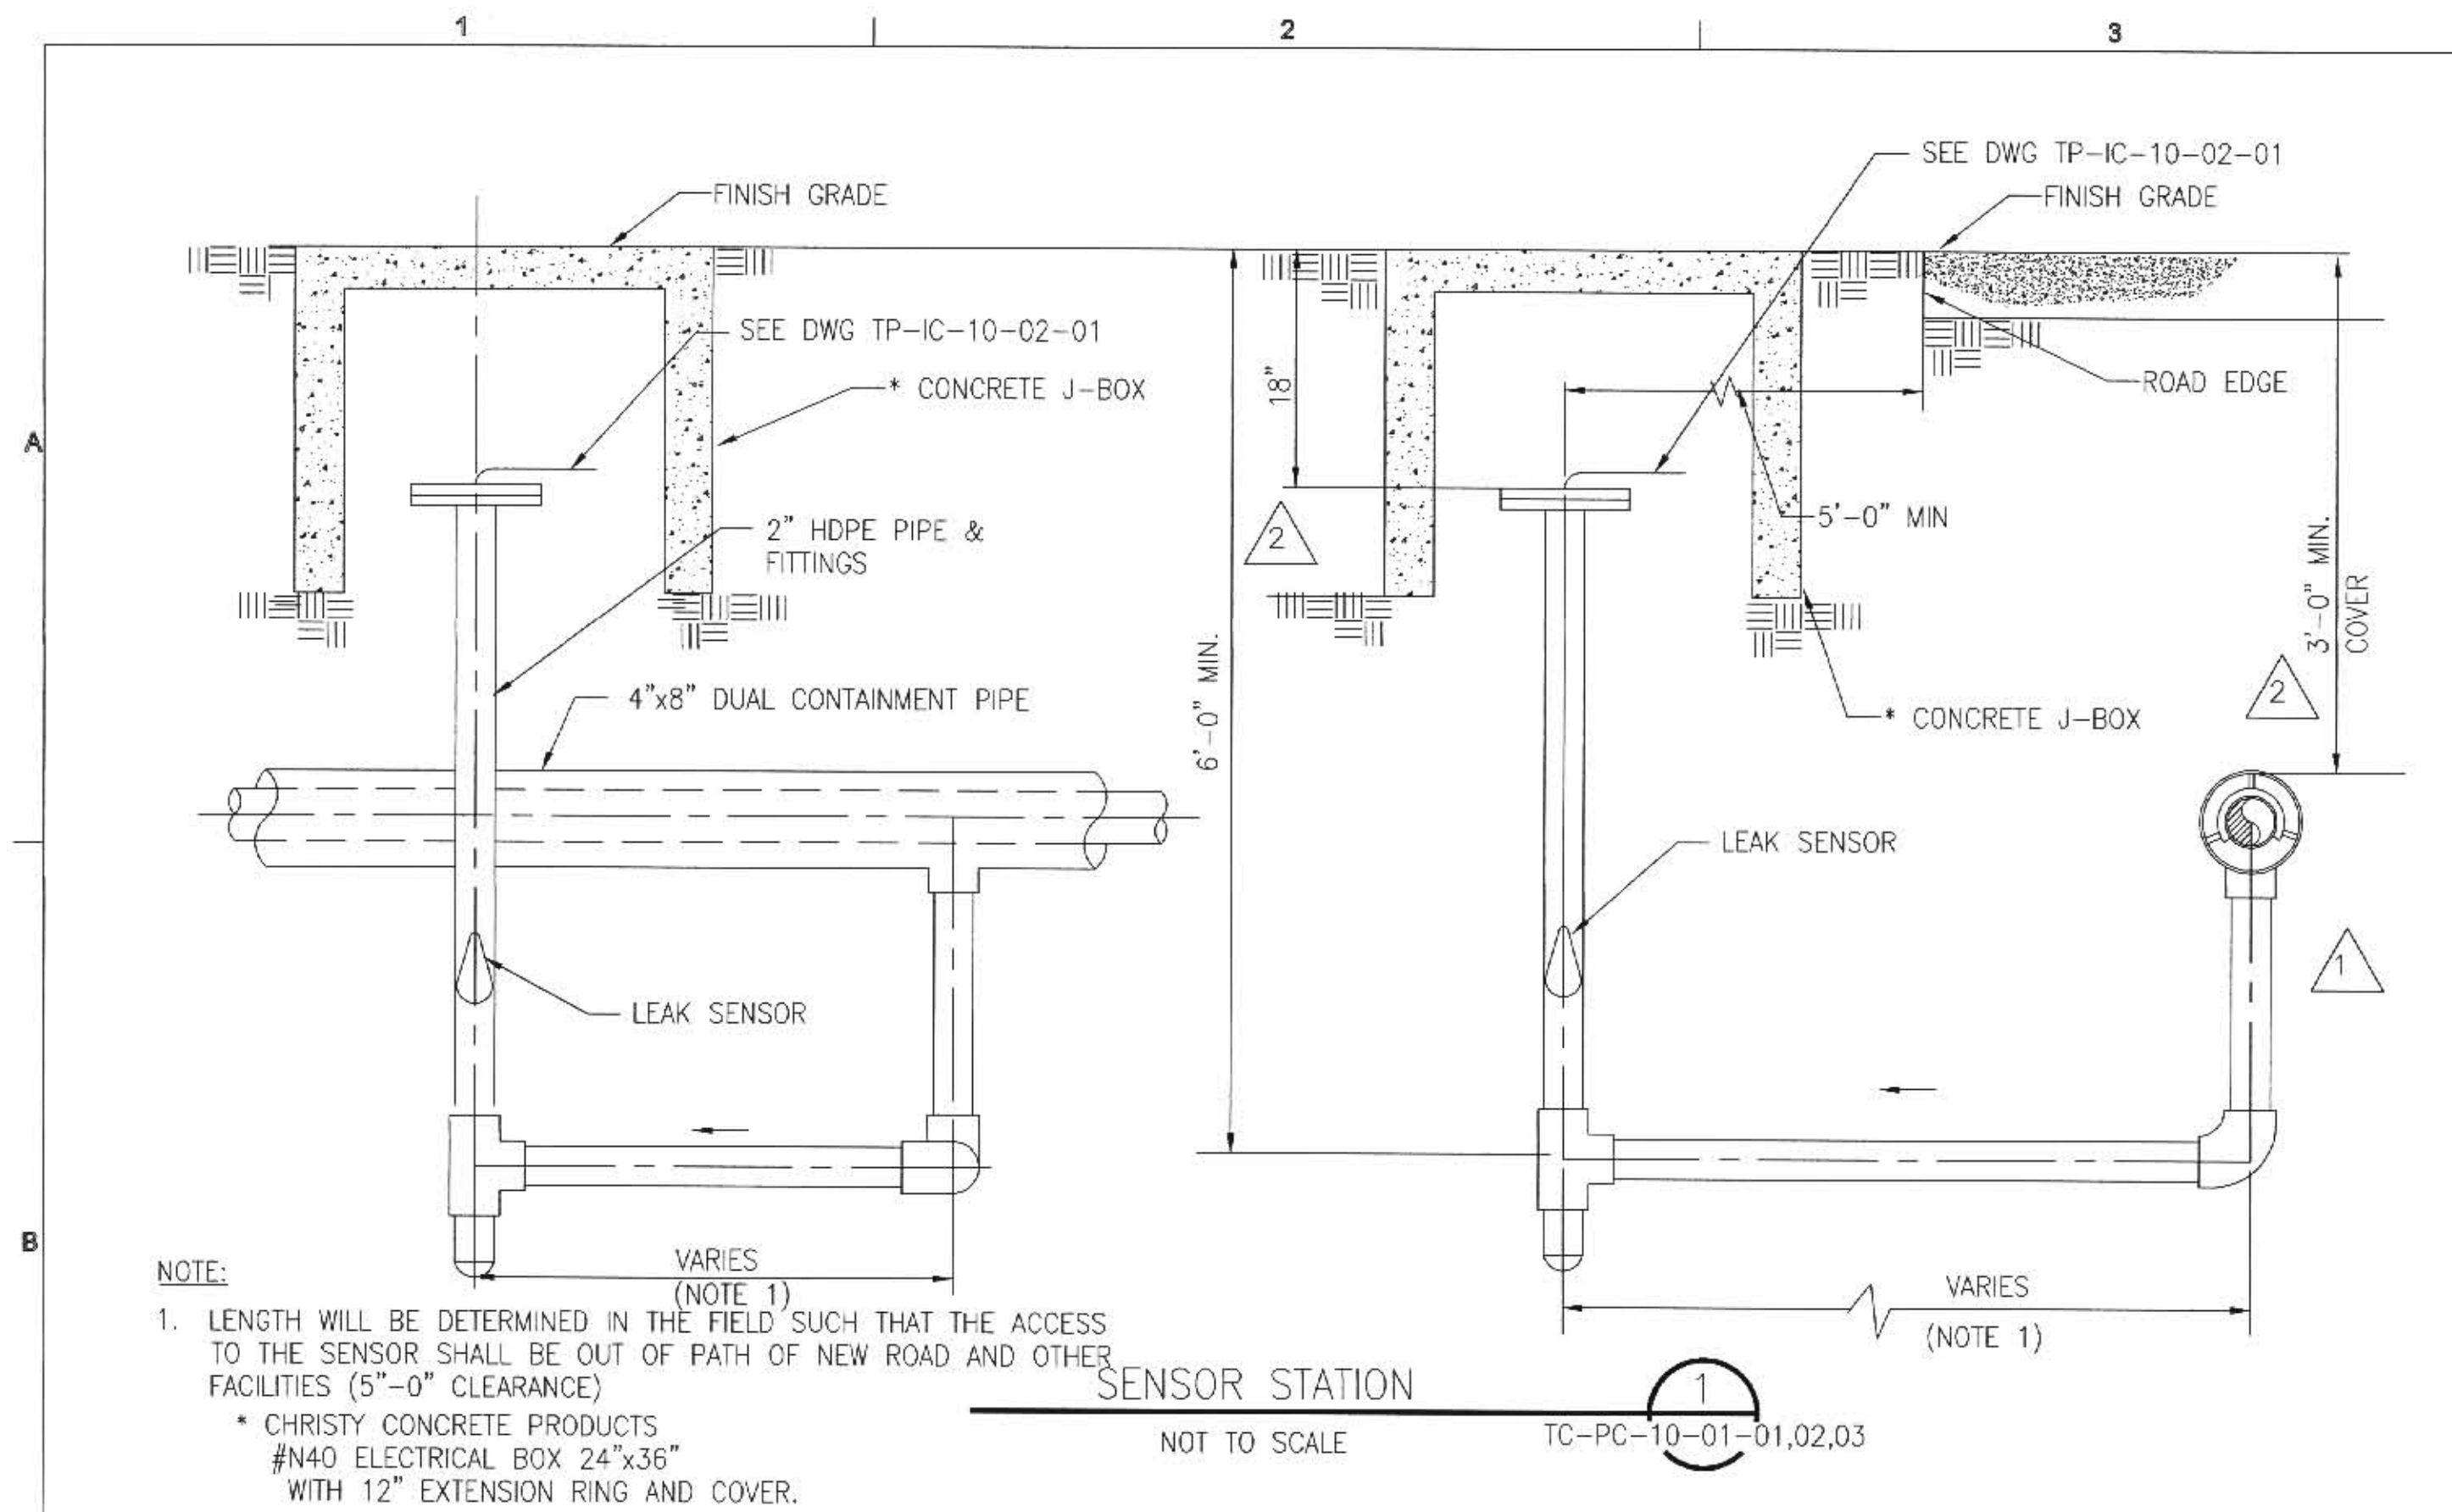


 <div>RESPONSIBLE ENGINEER DOUGLAS W. LANDWEHR PE# CE-C68846</div>	NO.	DATE	REVISION	BY	CHK	REVISION APPROVAL		REV	4	DATE 02/15/05	PRINT	STATUS				PACIFIC GAS & ELECTRIC CO. TOPOCK COMPRESSOR STATION INTERIM MEASURE 3 EXPANDED GROUNDWATER EXTRACTION AND TREATMENT SYSTEM		PILING DETAIL SHEET 1	
	ISSUED	REV	DATE	SDE	PEM														
	0	8/04	APPROVED FOR CONSTRUCTION	ABH	DWL	DISCIPLINE	REVIEWED	DISCIPLINE	REVIEWED	DATE	DISTRIBUTION	ISSUED	REV	DATE	SDE	PEM			
	1	8/04	REVISED AS NOTED	ABH	DWL	CIVIL		ELECTRICAL		REVIEWED	STATUS	PRELIMINARY							
	2	9/04	REVISED AS NOTED	ABH	DWL	STRUCTURAL	—	INST. & CONTROL		REVIEWED	REV.	FOR REVIEW AND APPROVAL	A	7/28/04	DWL				
	3	11/04	REVISED AS NOTED	ABH	DWL	MECHANICAL	AS	ARCHITECTURAL		REVIEWED	CLIENT	APPROVED FOR CONSTRUCTION	0	8/06/04	DWL				
	4	02/05	REVISED PIPE MATERIAL	WHD	DWL	PROCESS	—	ENVIRONMENTAL		REVIEWED	FIELD	REVISED & APPROVED FOR CONSTRUCTION	4	3/8/05	SDE	AS			
						PIPING	SDH	GEN. ARRANG.		PP	INTRA CO.								





BAR IS ONE INCH ON ORIGINAL DRAWING.  
0 1"

THIS DOCUMENT, AND THE IDEAS AND DESIGNS INCORPORATED HEREIN, AS AN INSTRUMENT OF PROFESSIONAL SERVICE, IS THE PROPERTY OF CH2M HILL AND IS NOT TO BE USED, IN WHOLE OR IN PART, FOR ANY OTHER PROJECT WITHOUT THE WRITTEN AUTHORIZATION OF CH2M HILL.




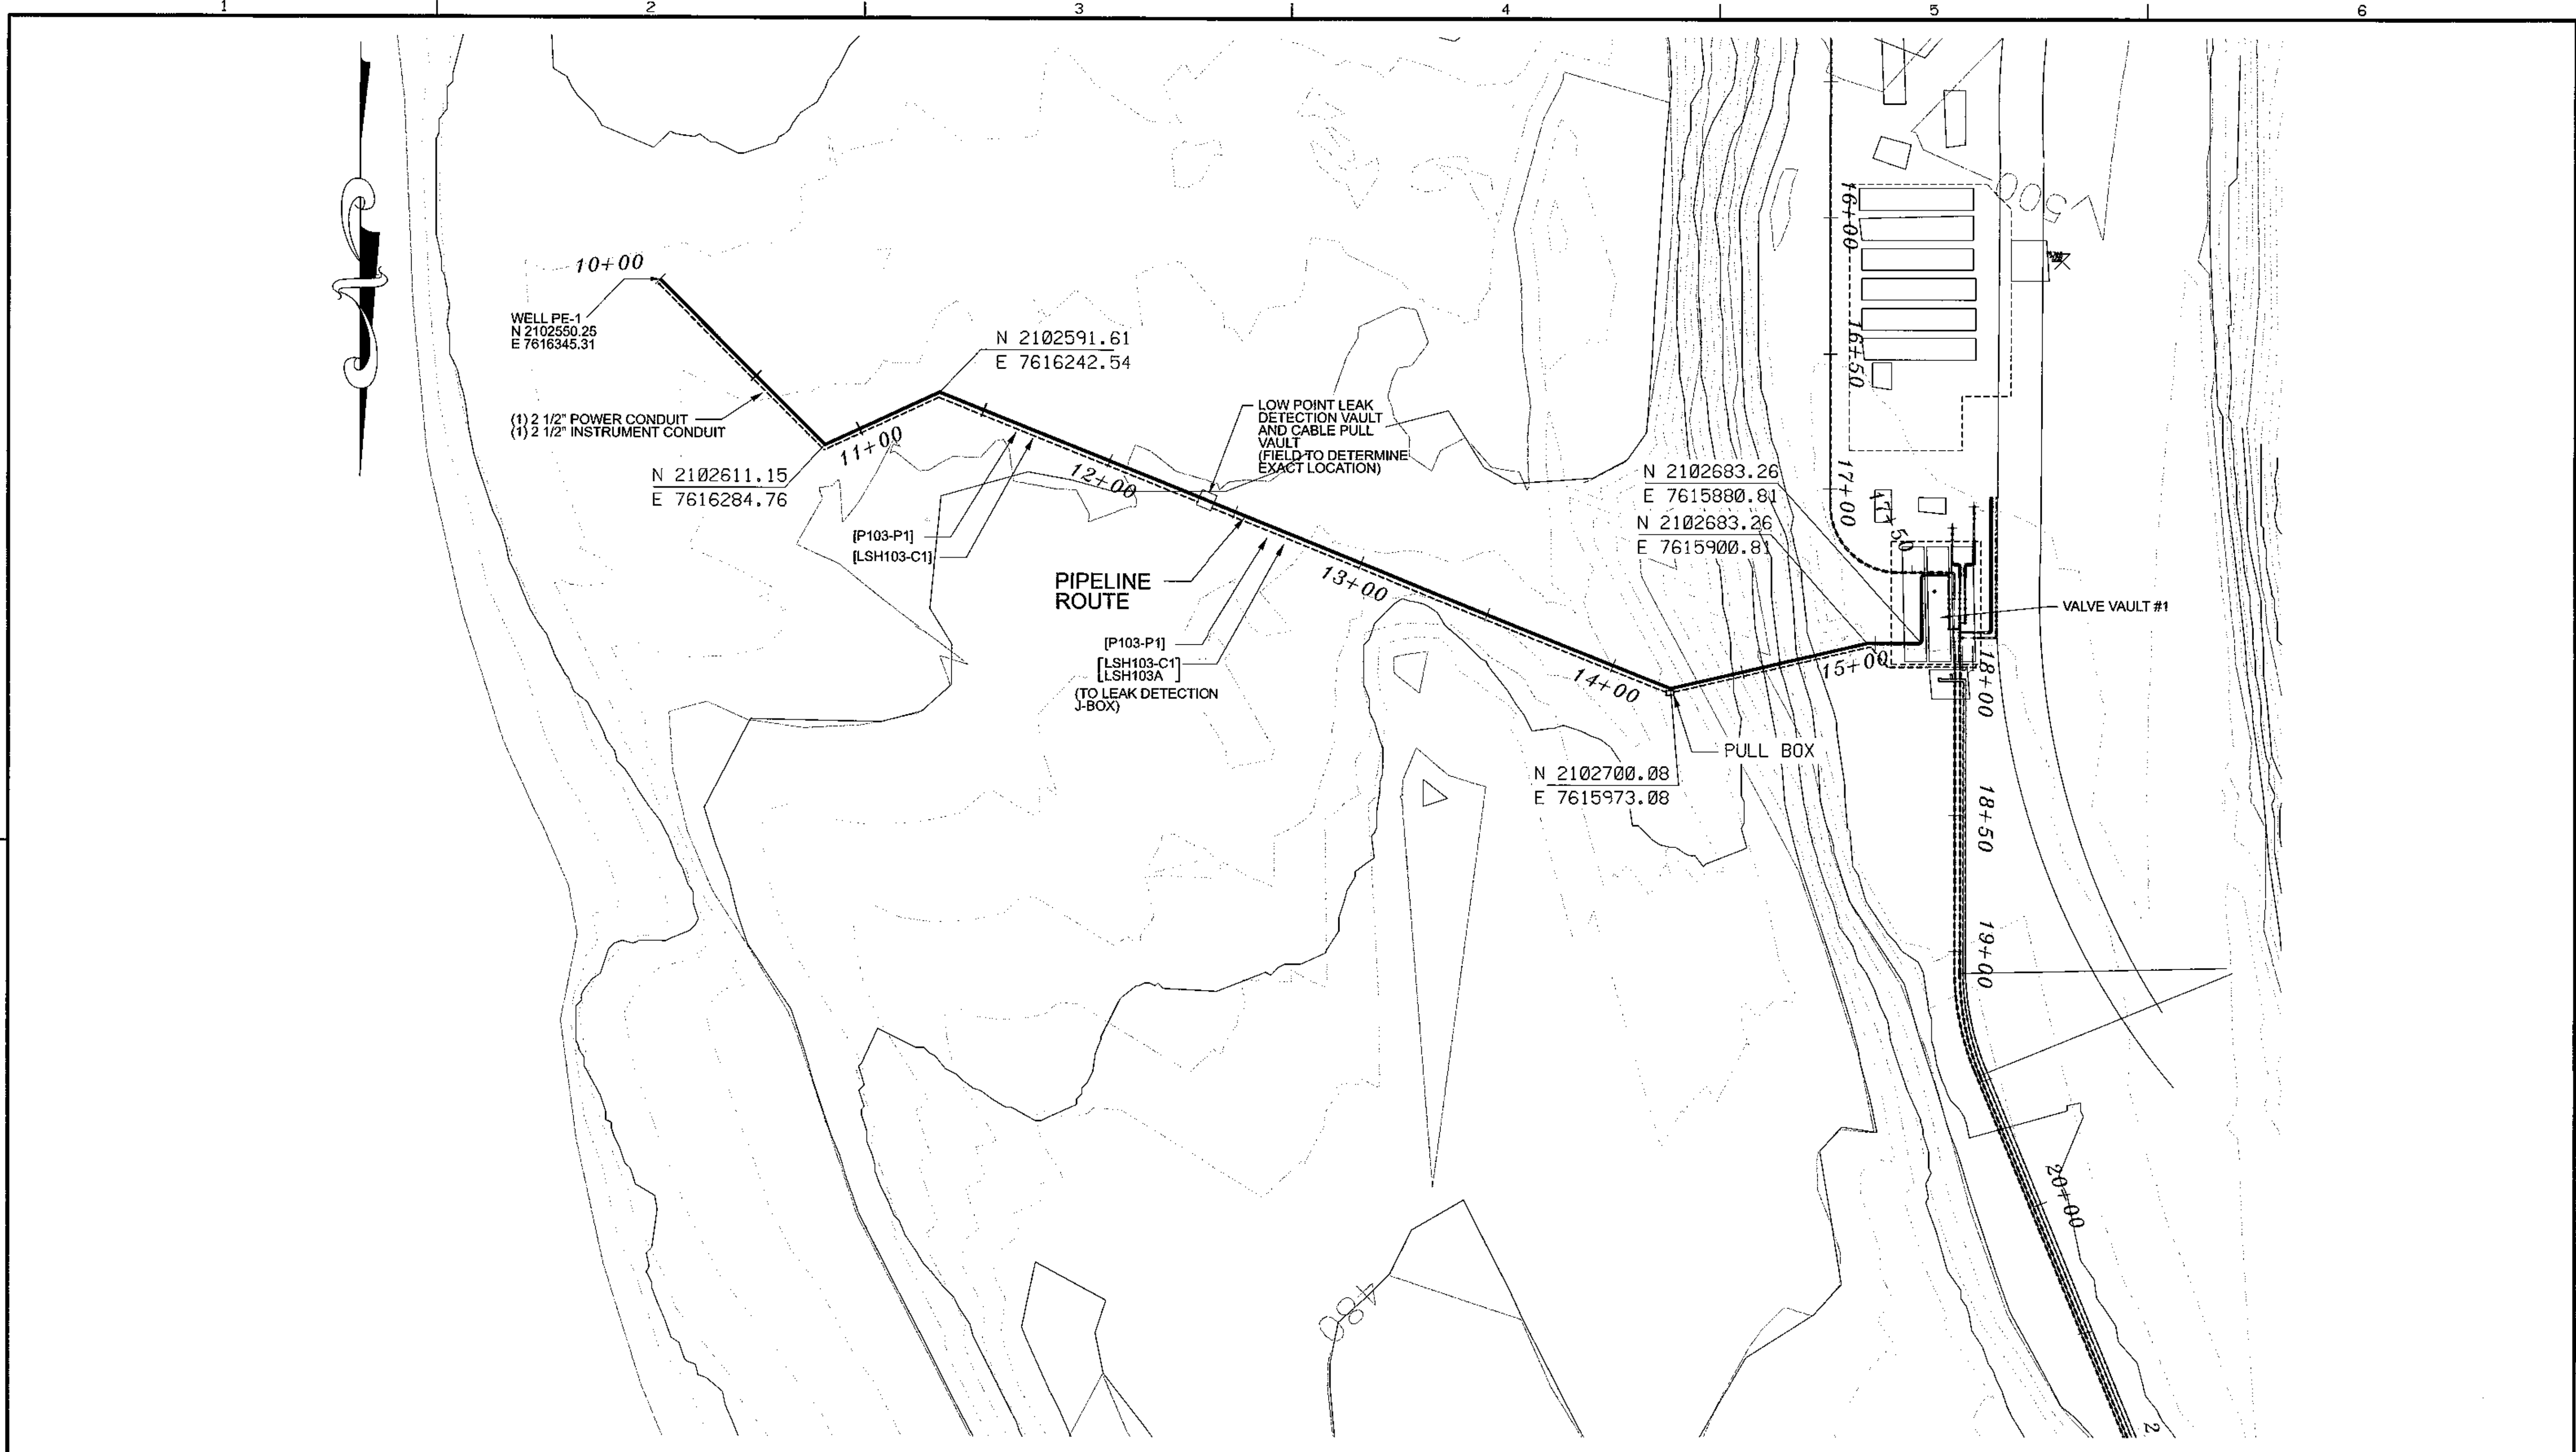


	RESPONSIBLE ENGINEER PE	NO.	DATE	REVISION	BY	CHK	REVISION APPROVAL		REV A	DATE 07/14/05	PRINT DISTRIBUTION	STATUS					PACIFIC GAS & ELECTRIC TOPOCK COMPRESSOR STATION INTERIM MEASURE 3 EXPANDED GROUNDWATER EXTRACTION AND TREATMENT SYSTEM  PROJECT NO. 327061  <b>CH2MHILL</b>	ELECTRICAL PLAN VIEW  PE-1 ELECTRICAL CONDUIT ROUTE		
		A	07/14/05	CONCEPTUAL LAYOUT FOR REVIEW AND COMMENT	JDS	KCM	DISCIPLINE	REVIEWED	DISCIPLINE	REVIEWED	DATE	ISSUED	REV	DATE	SDE	PEM		DWG. NO. TP-EE-20-01-24	REV. A	
							CIVIL	-	ELECTRICAL	KCM	STATUS	PRELIMINARY								
							STRUCTURAL	-	INST & CONTROL	KCM	REV.	FOR REVIEW AND APPROVAL	A	07/14/05	KCM	AJ				
							MECHANICAL	-	ARCHITECTURAL	-	CLIENT	APPROVED FOR CONSTRUCTION								
							PROCESS	-	ENVIRONMENTAL	-	FIELD	REVISED & APPROVED FOR CONSTRUCTION								
							PIPING	-	GEN. ARRANG.	-	INTRA CO.									
SCALE 1"=30'																				

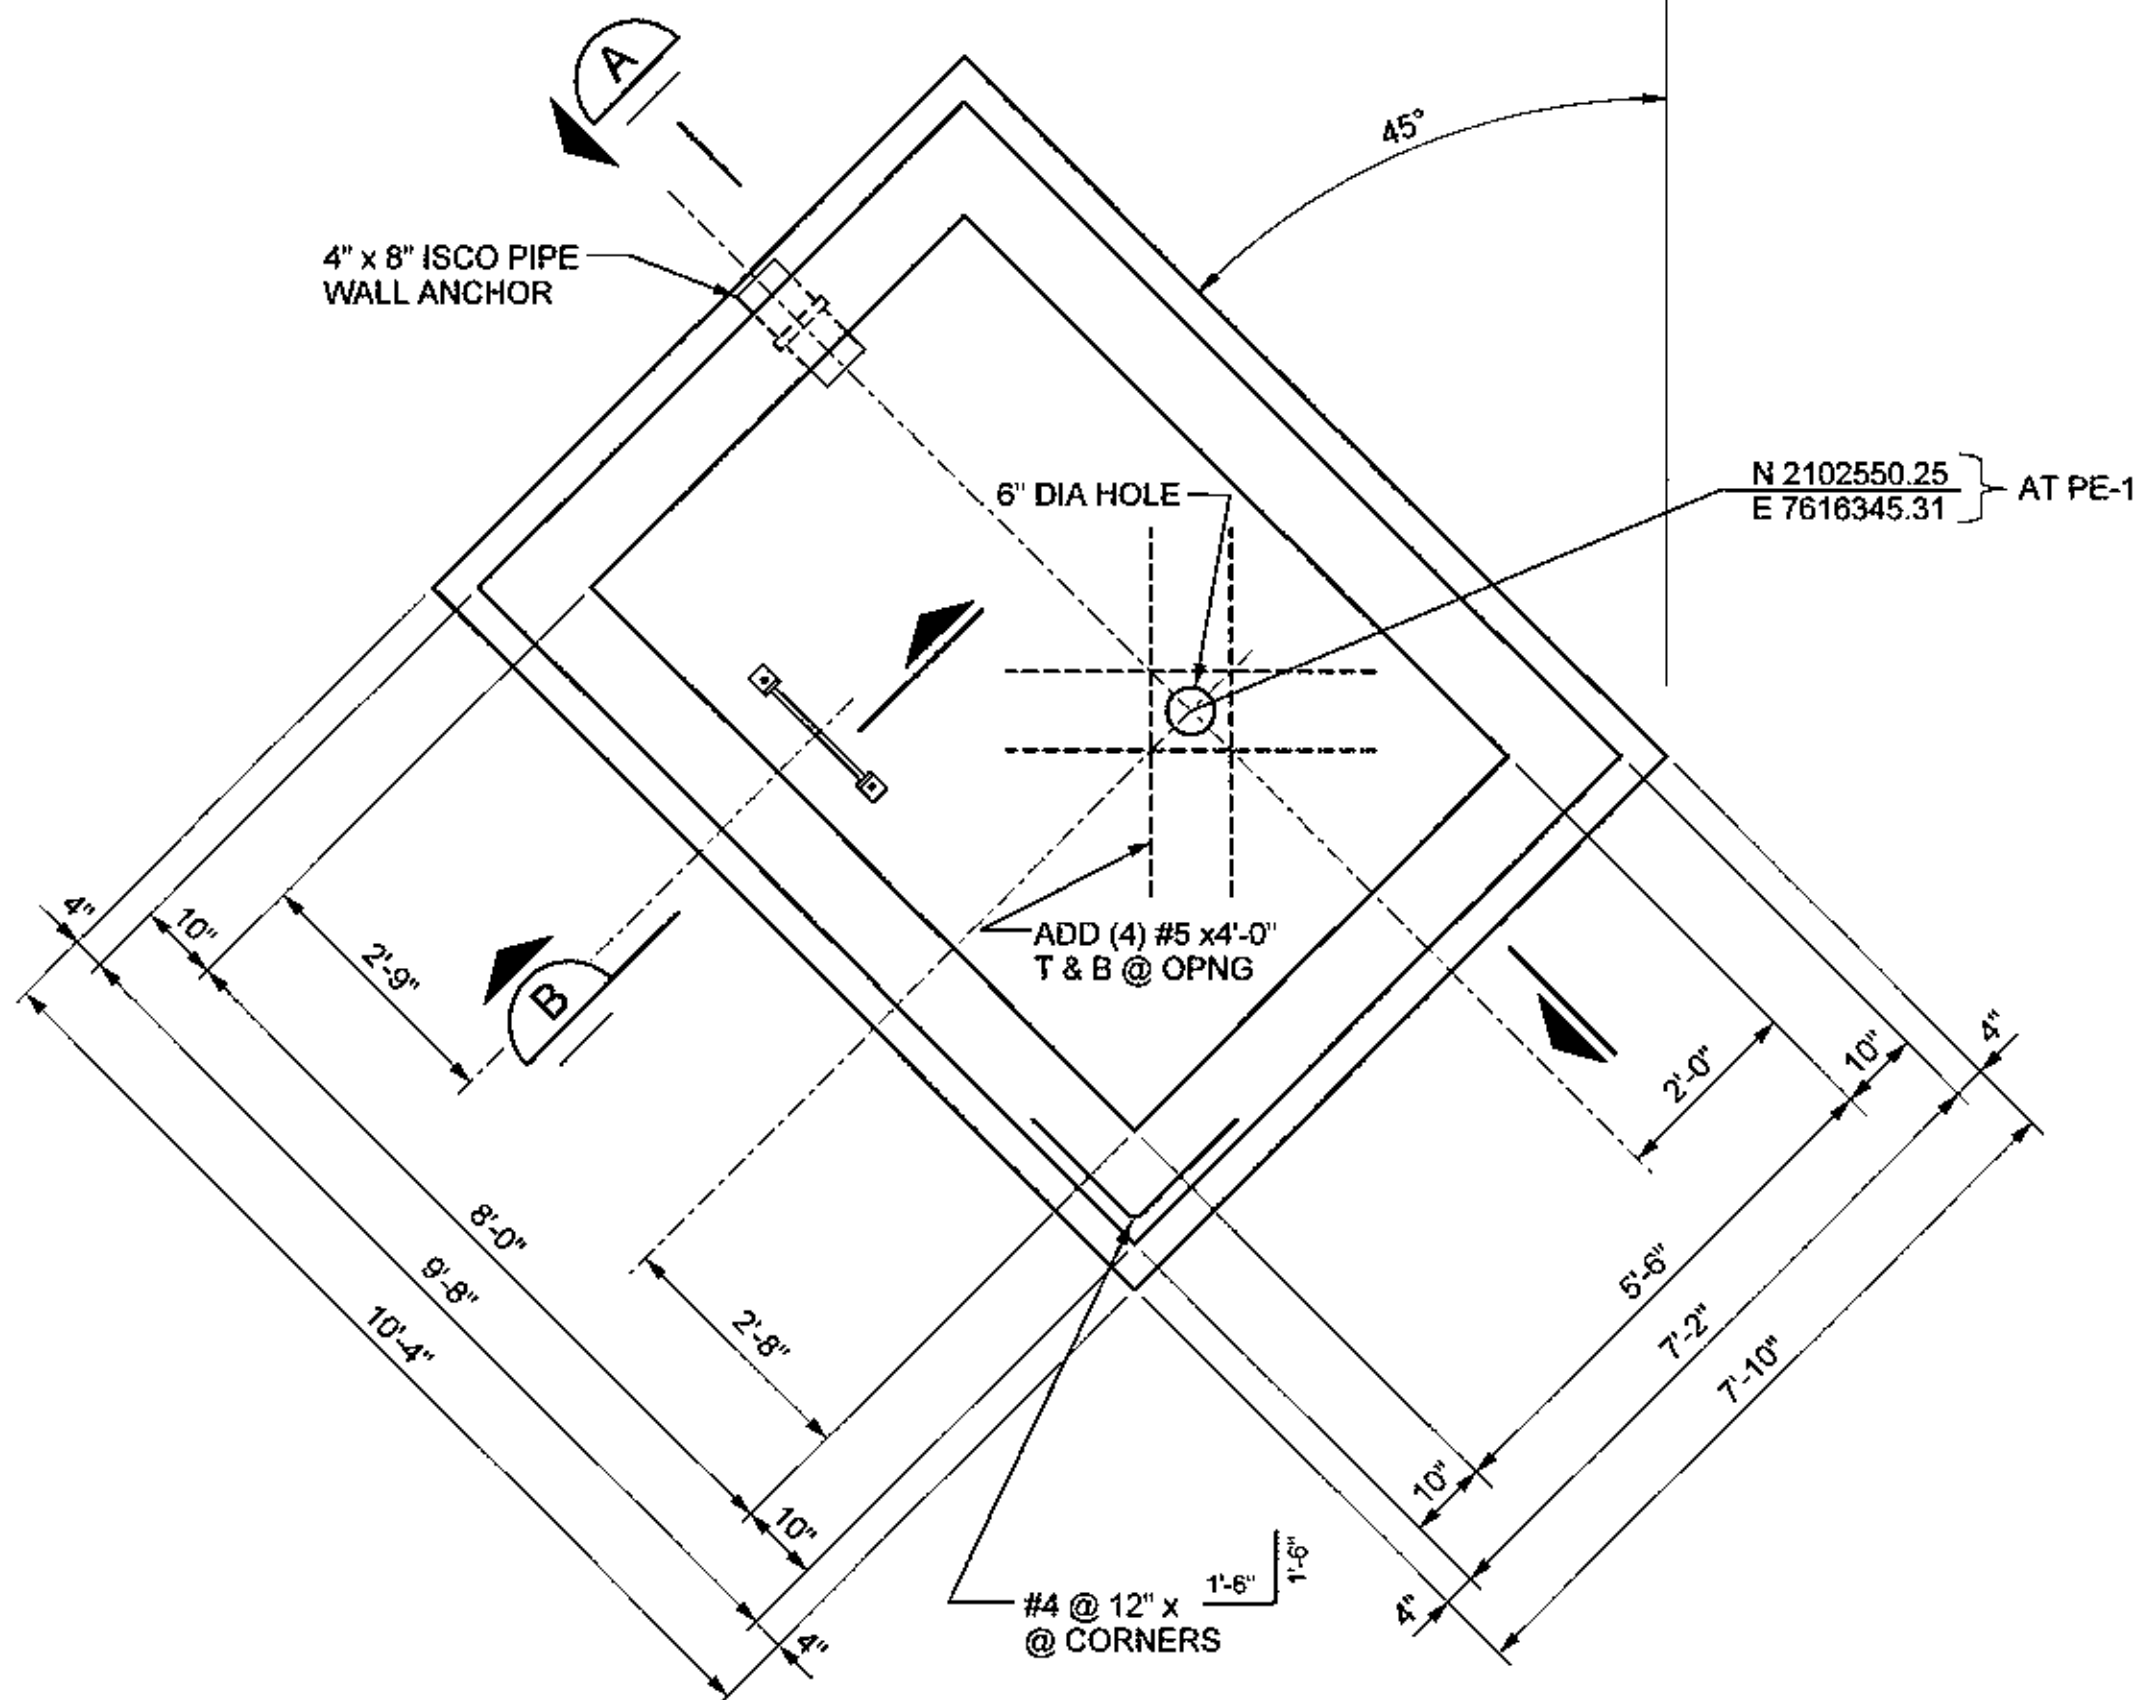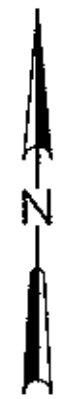

WELL VAULT DETAIL 1  
1/2"=1'-0"

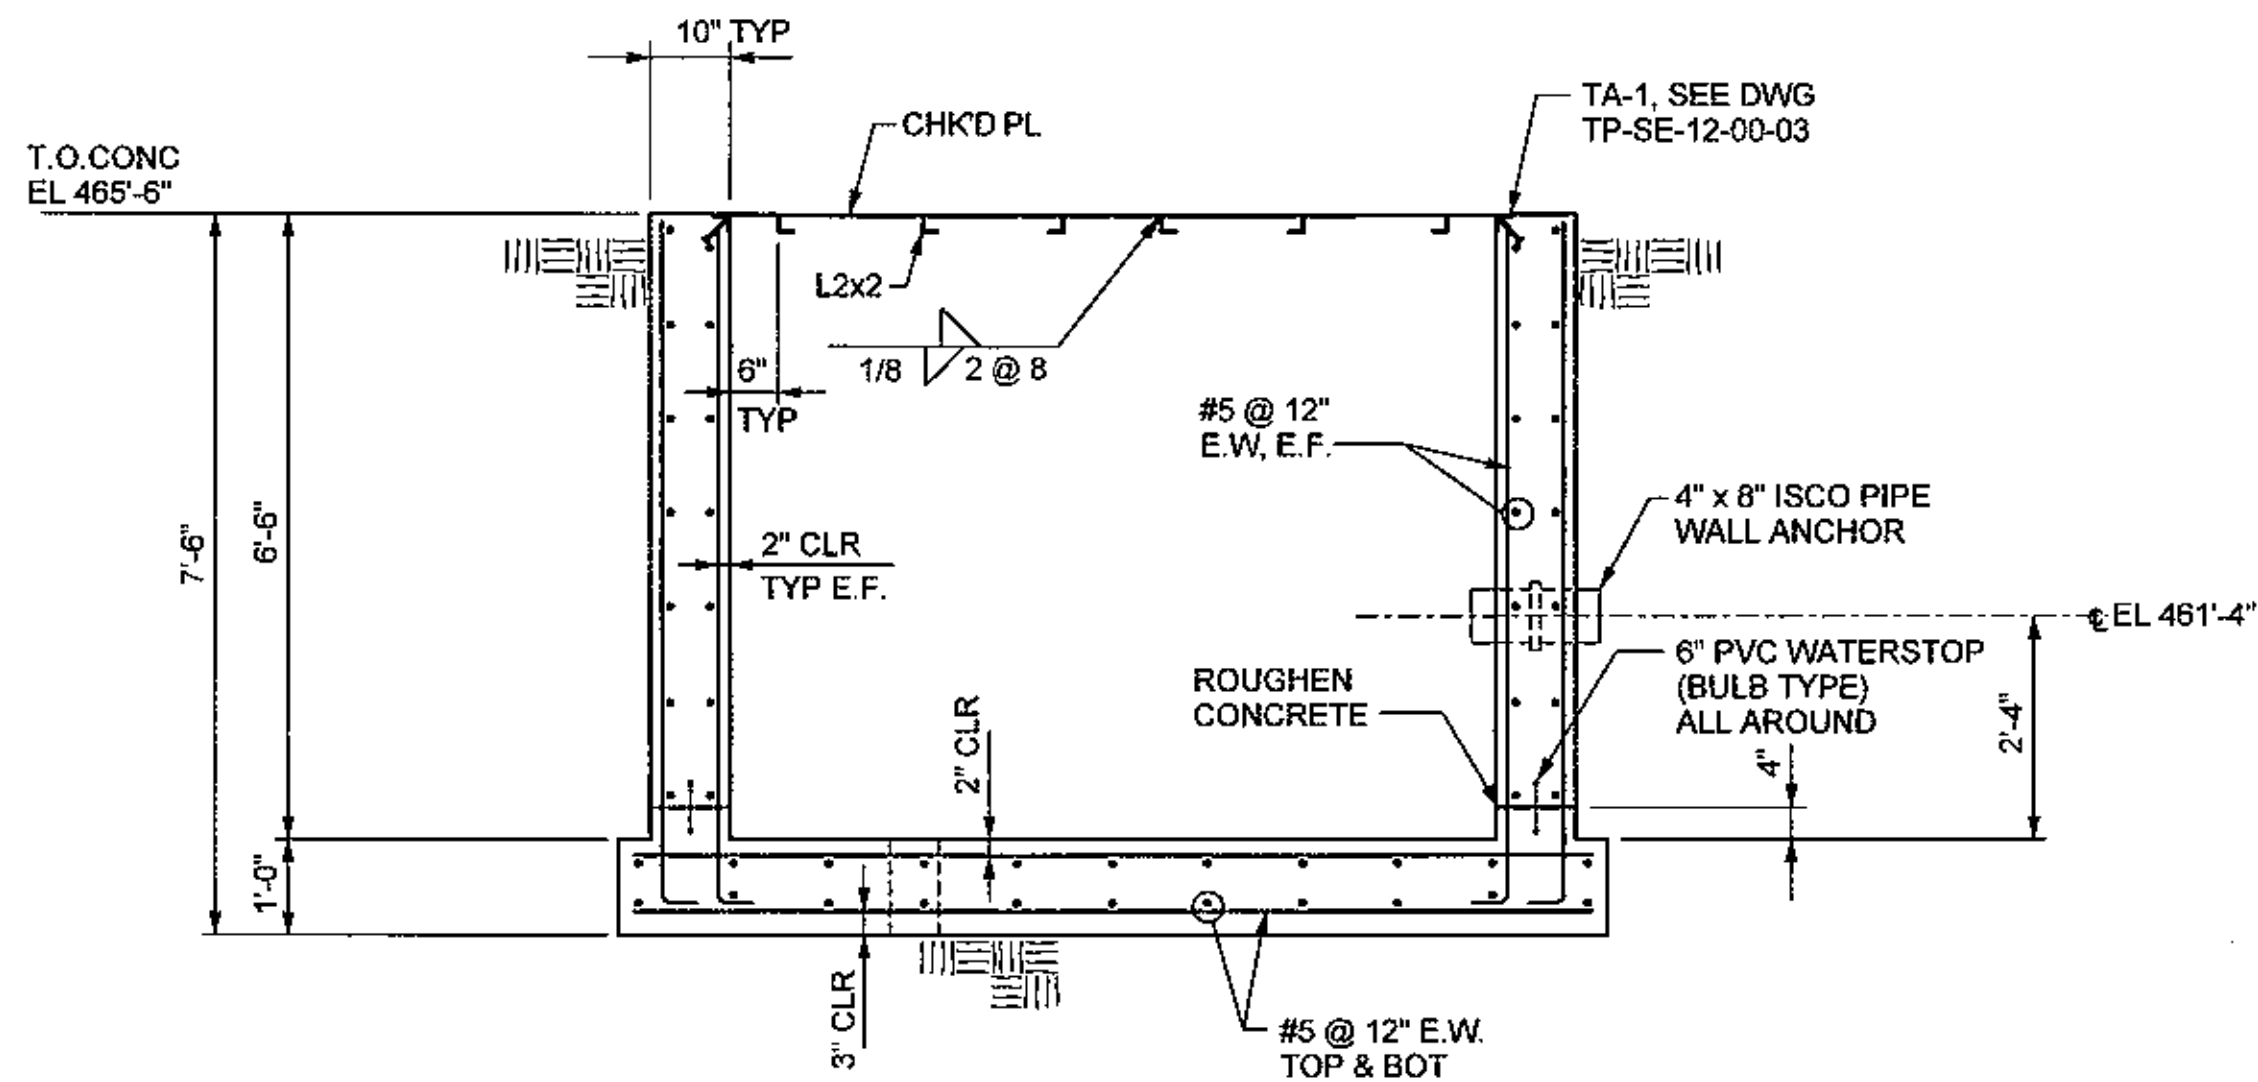


SECTION A  
1/2"=1'-0"

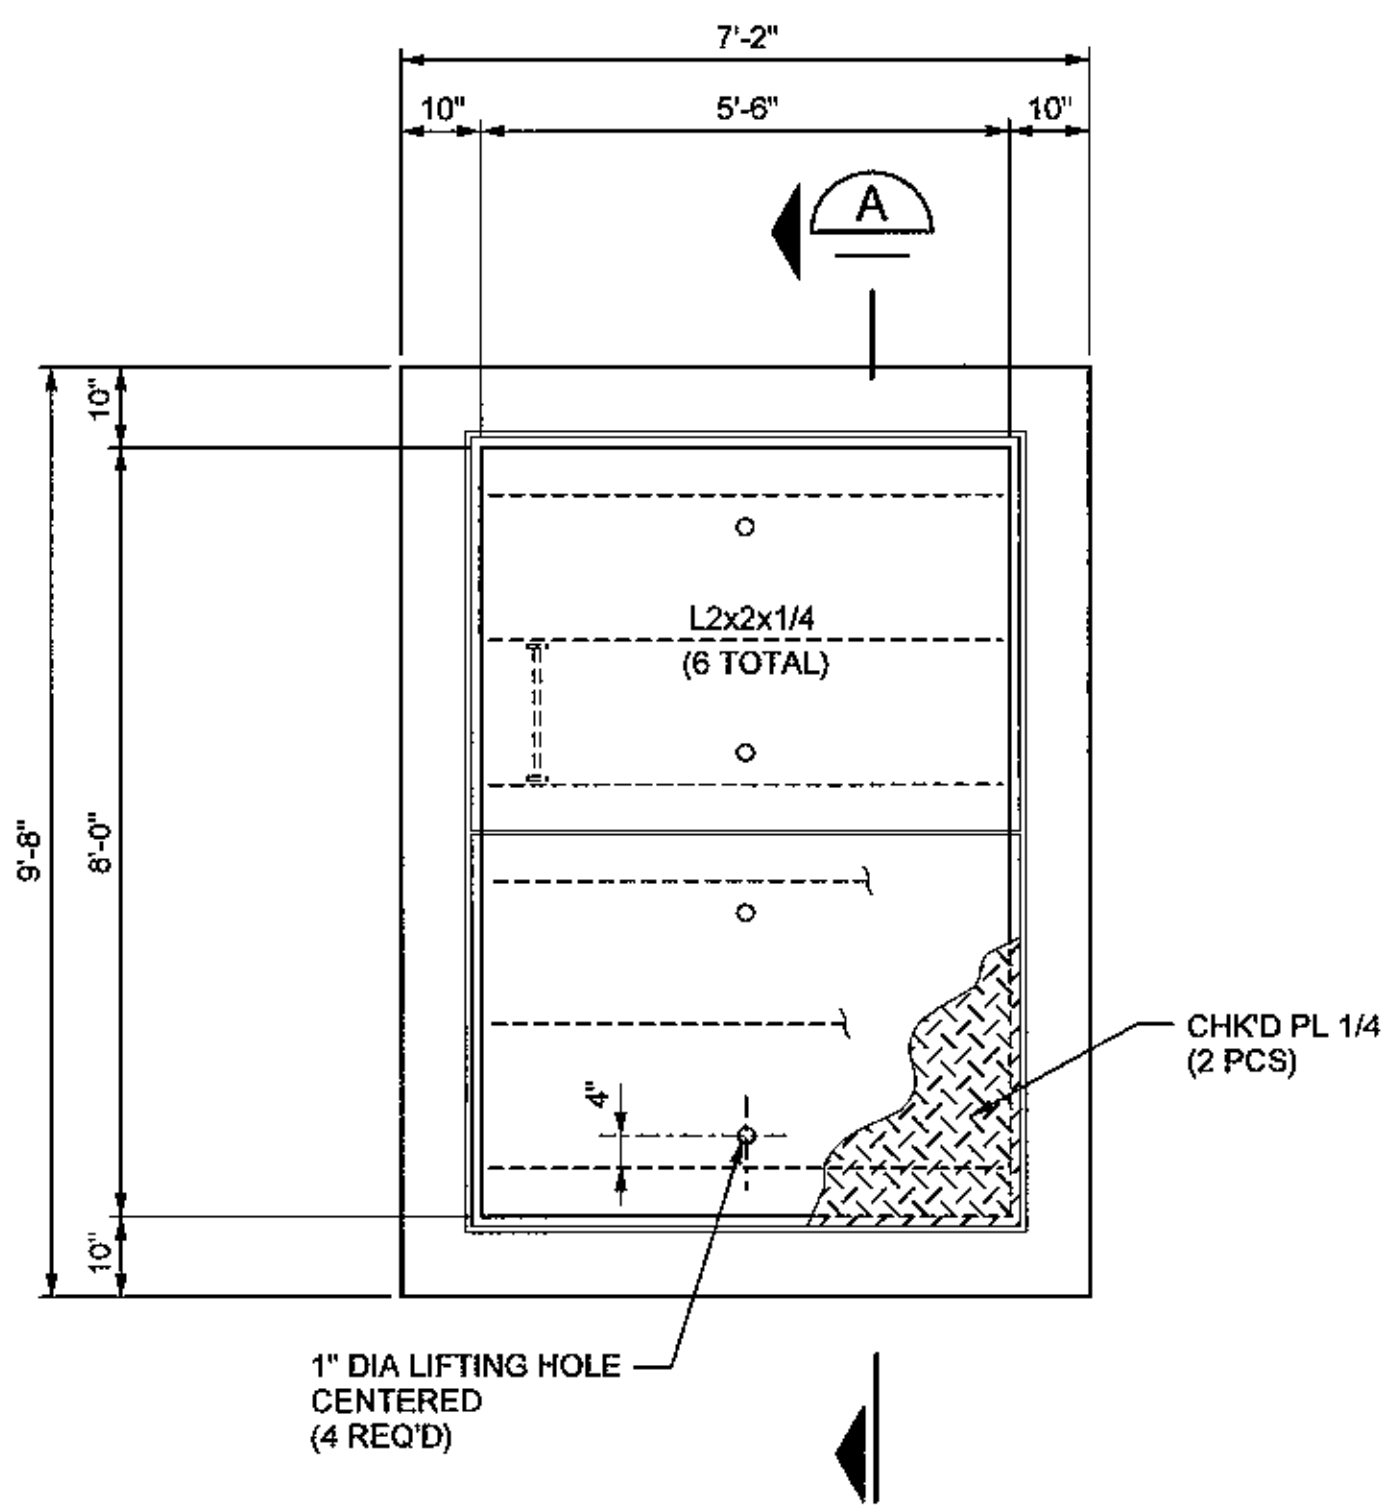

NOTE: 2 REQ'D

WELL VAULT TOP VIEW  
1/2"=1'-0"

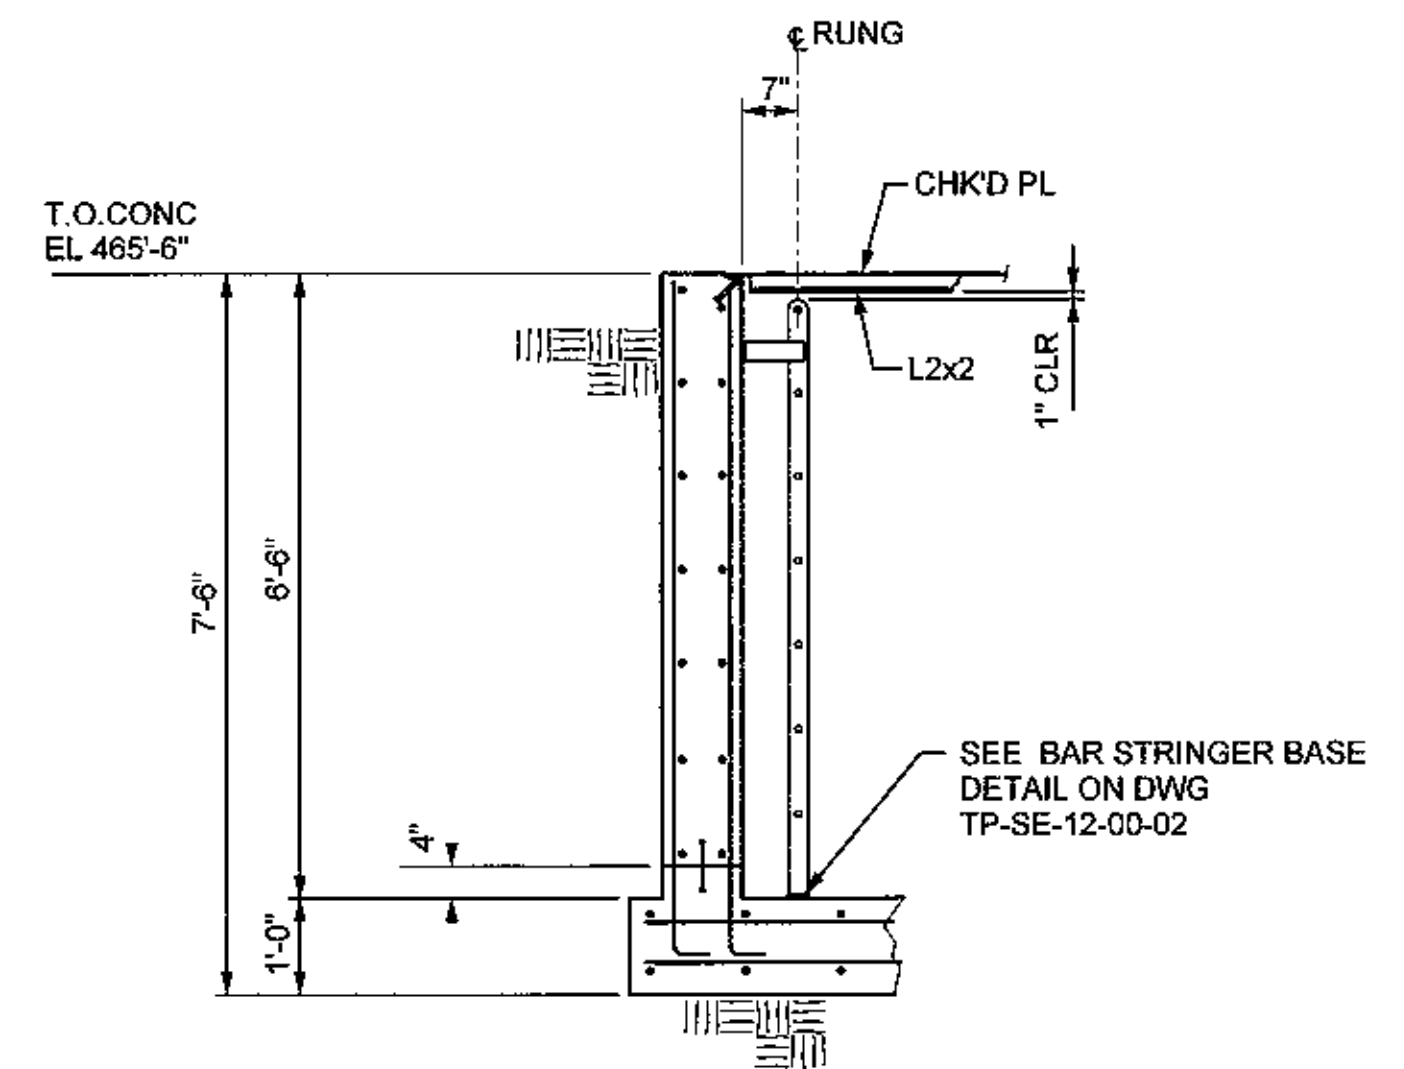

SECTION B  
1/2"=1'-0"

NOTES:

1. FOR GENERAL NOTES AND STANDARD DETAILS SEE DRAWINGS TP-SE-12-00-01 THRU 03.
2. WORK THIS DRAWING WITH DWGS TP-SE-20-00-01 THRU 10.



RESPONSIBLE ENGINEER:  
MARIO N. SCACCO  
PE # 37744

NO.	DATE	REVISION	BY	CHK	REVISION APPROVAL	REV 0	DATE 07/18/05	PRINT DISTRIBUTION	STATUS
0	07/18/05	APPROVED FOR CONSTRUCTION	EFC	MNS	DISCIPLINE	REVIEWED	DISCIPLINE	REVIEWED	DATE
					CIVIL	<i>MNS</i>	ELECTRICAL		STATUS
					STRUCTURAL	<i>MNS</i>	INST & CONTROL		REV.
					MECHANICAL		ARCHITECTURAL		CLIENT
					PROCESS		ENVIRONMENTAL		FIELD
					PIPING		GEN. ARRANG.		INTRA CO.

SCALE AS NOTED


PACIFIC GAS & ELECTRIC CO.  
TOPOCK COMPRESSOR STATION  
INTERIM MEASURE 3  
EXPANDED GROUNDWATER EXTRACTION  
AND TREATMENT SYSTEM


PROJ NO. 315994


**CH2MHILL**

CONCRETE  
PE-1 WELL VAULT #3  
SECTIONS & DETAILS  
SHEET 1


DWG. NO. TP-SE-20-00-15 REV. 0

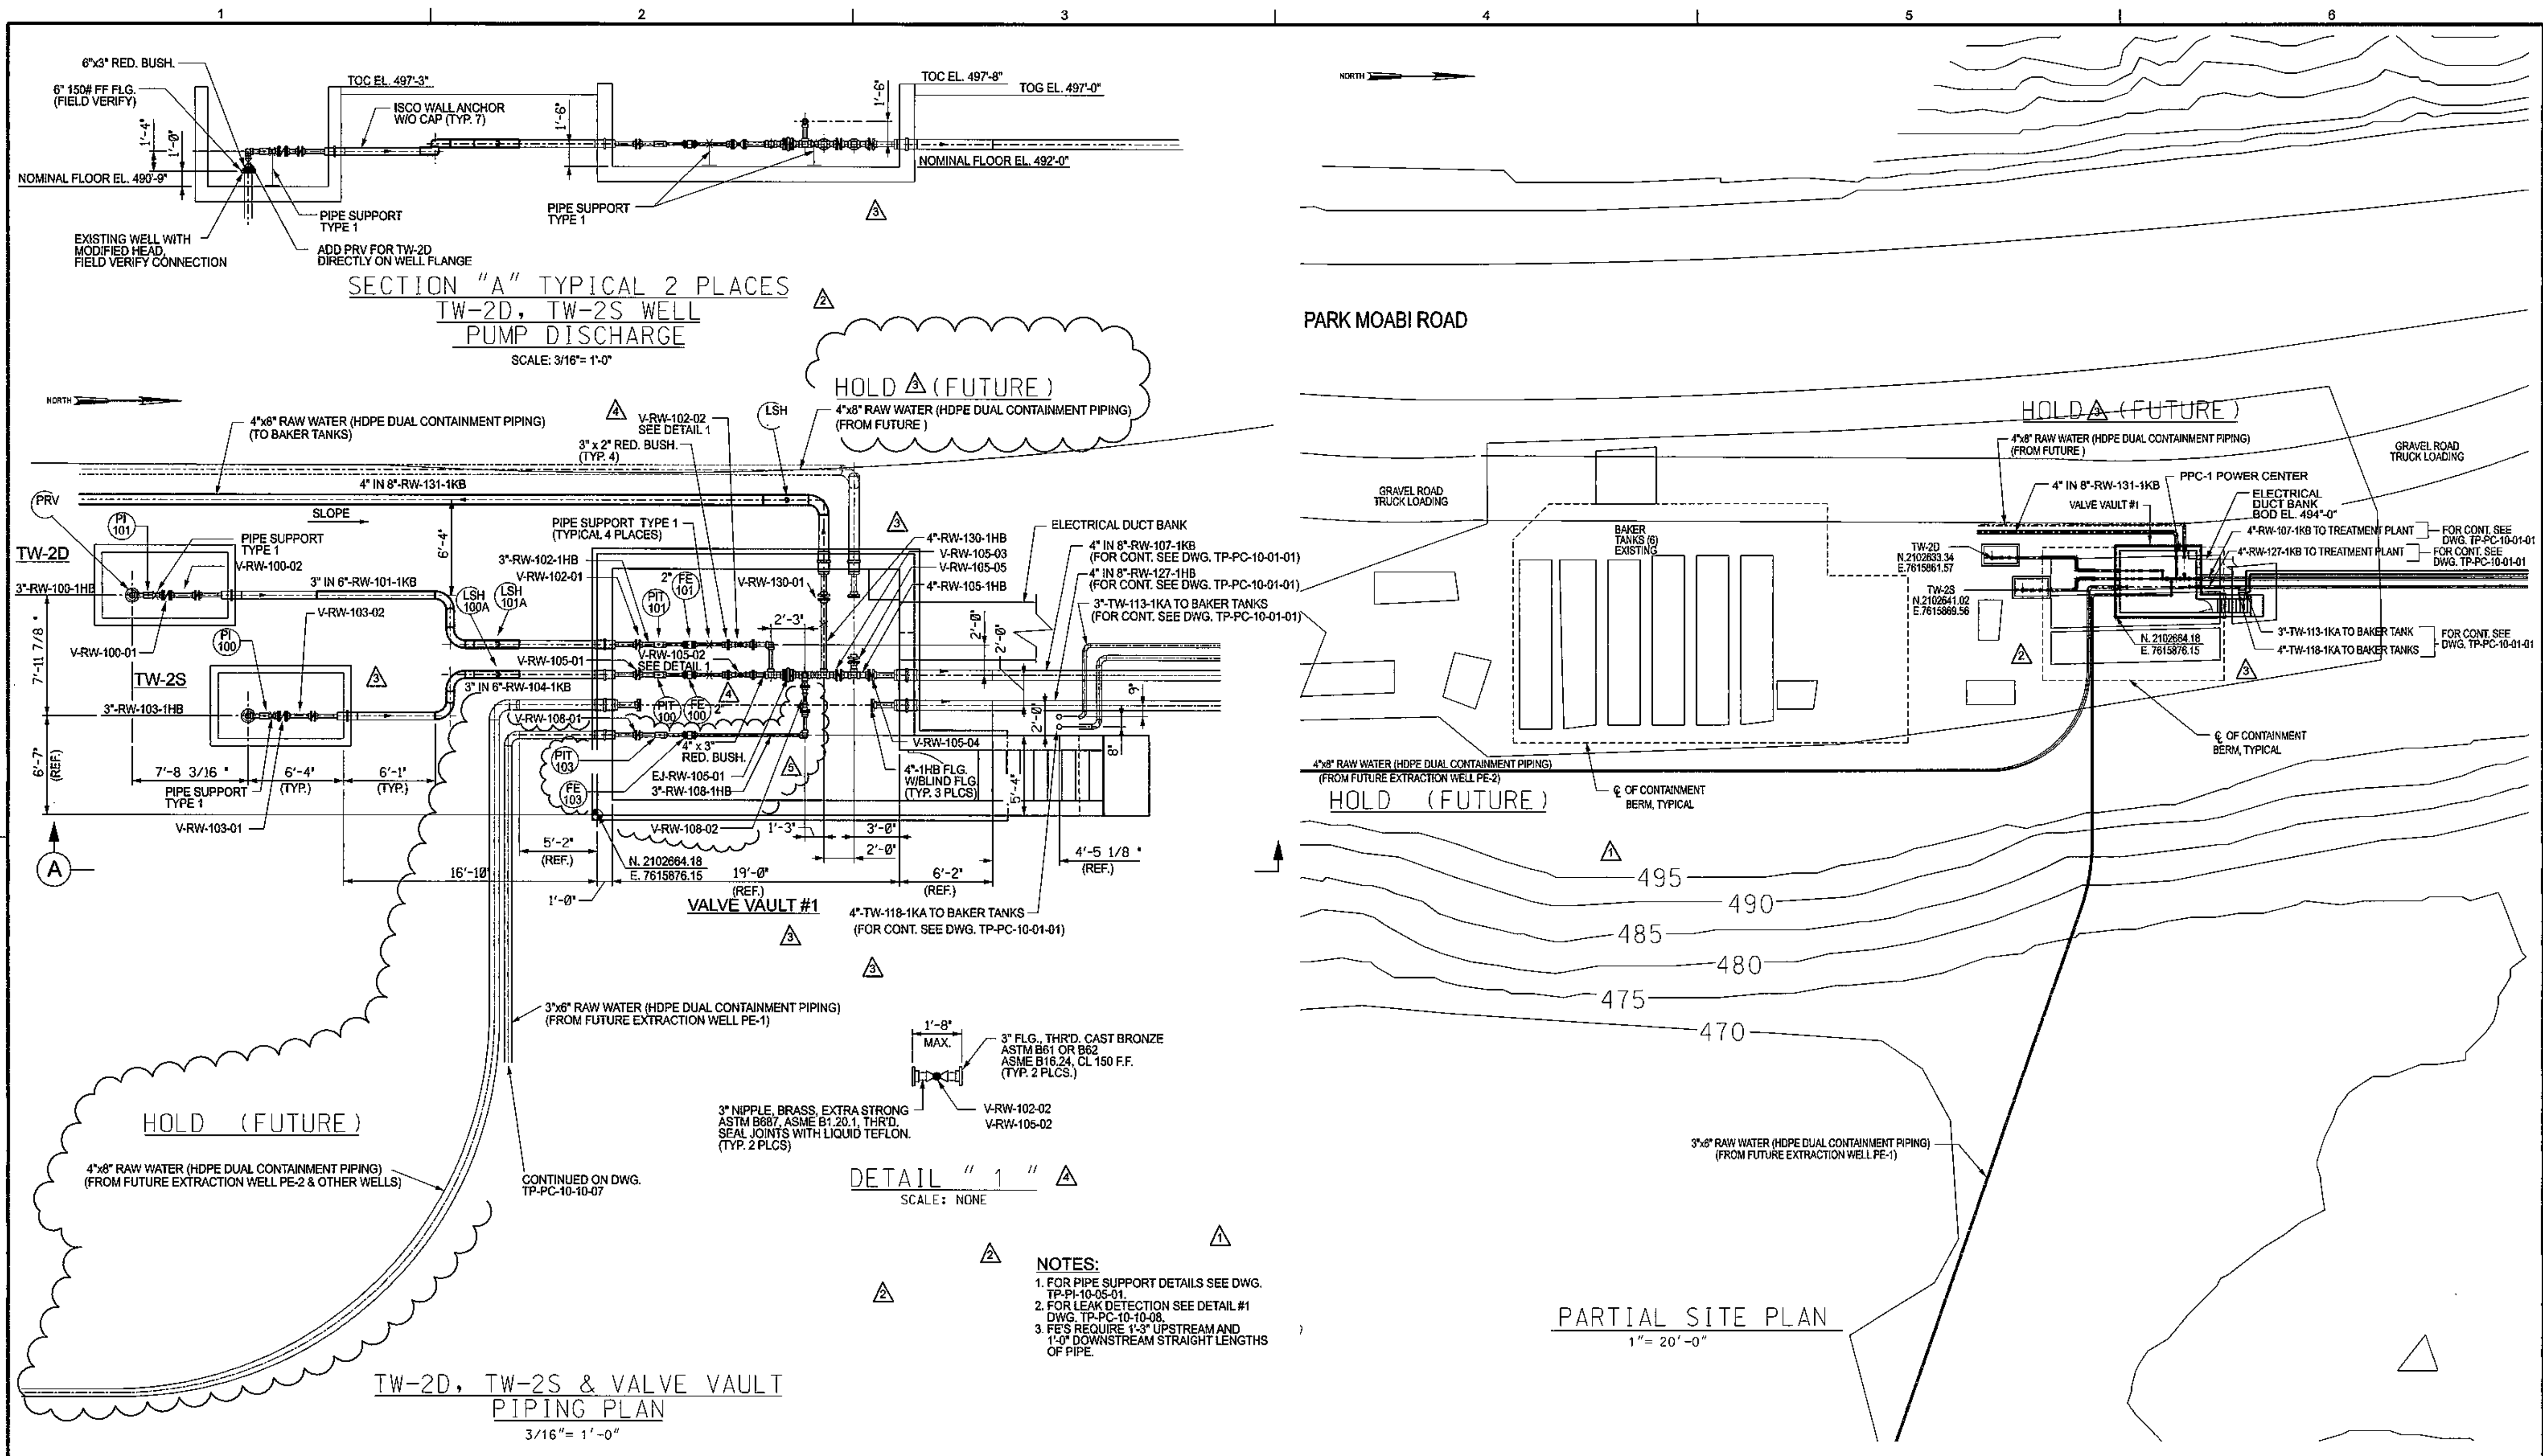


	RESPONSIBLE ENGINEER: STEVEN D. HOYER PE# CA M31888	NO.	DATE	REVISION	BY	CHK	REVISION APPROVAL		REV 5	DATE 07/14/05	PRINT DISTRIBUTION	STATUS					PACIFIC GAS & ELECTRIC CO. TOPOCK COMPRESSOR STATION INTERIM MEASURE 3 EXPANDED GROUNDWATER EXTRACTION AND TREATMENT SYSTEM PROJ NO. 315994  <b>CH2MHILL</b>	UNDERGROUND PIPING EXTRACTION WELLS TW-2D AND TW-2S WELL VAULTS BENCH SITE 20 VALVE VAULT  DWG. NO. TP-PI-20-02-02 REV. 5		
		0	08/31/04	APPROVED FOR CONSTRUCTION	WHD	SDH	DISCIPLINE	REVIEWED	DISCIPLINE	REVIEWED	DATE		ISSUED	REV	DATE	SDE				PEM
		1	10/01/04	REVISED AS NOTED	ASH	SDH	CIVIL		ELECTRICAL		STATUS		PRELIMINARY		/ /					
		2	10/20/04	REVISED AS NOTED	WHD	SDH	STRUCTURAL		INST & CONTROL		REV.		FOR REVIEW AND APPROVAL		/ /					
		3	01/31/05	REVISED VALVE VAULT PIPING LAYOUT AND ELEVATIONS	WHD	SDH	MECHANICAL		ARCHITECTURAL		CLIENT		APPROVED FOR CONSTRUCTION	0	9/2/04	SDH				TP
		4	03/08/05	ADDED DETAIL 1	WHD	SDH	PROCESS		ENVIRONMENTAL		FIELD		REVISED & APPROVED FOR CONSTRUCTION	5	07/14/05	SDH				
		5	07/14/05	REVISED VALVE VAULT #1 PIPING PLAN	EFC		PIPING	SDH	GEN. ARRANG.		INTRA CO.		SCALE AS NOTED							
			/ /																	
			/ /																	
			/ /																	

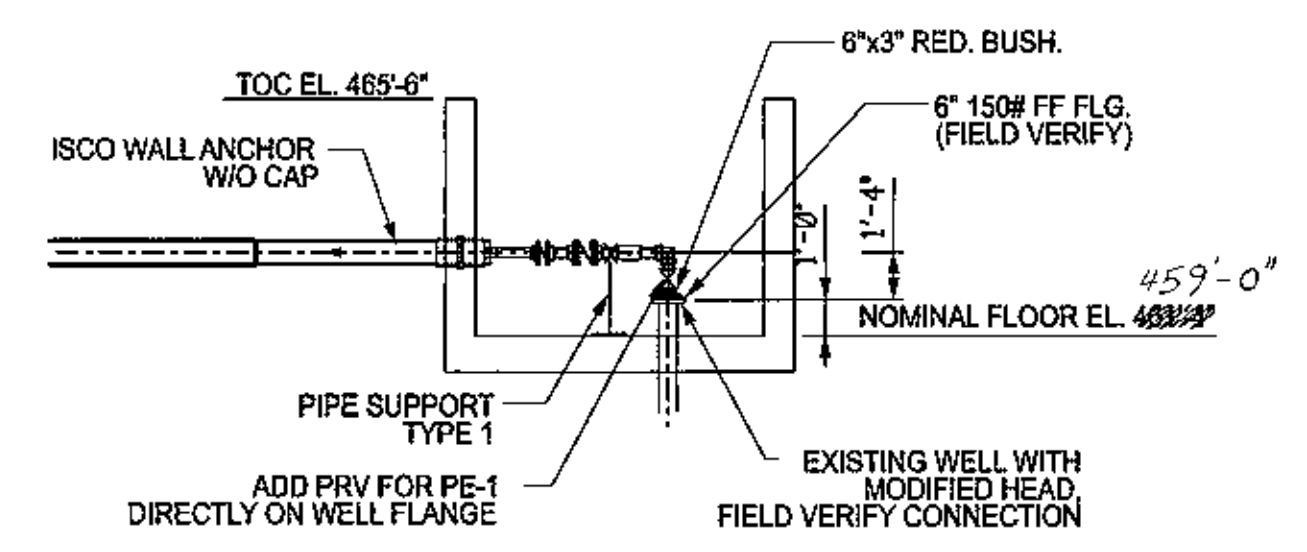

SECTION "A"  
PE-1 WELL  
PUMP DISCHARGE

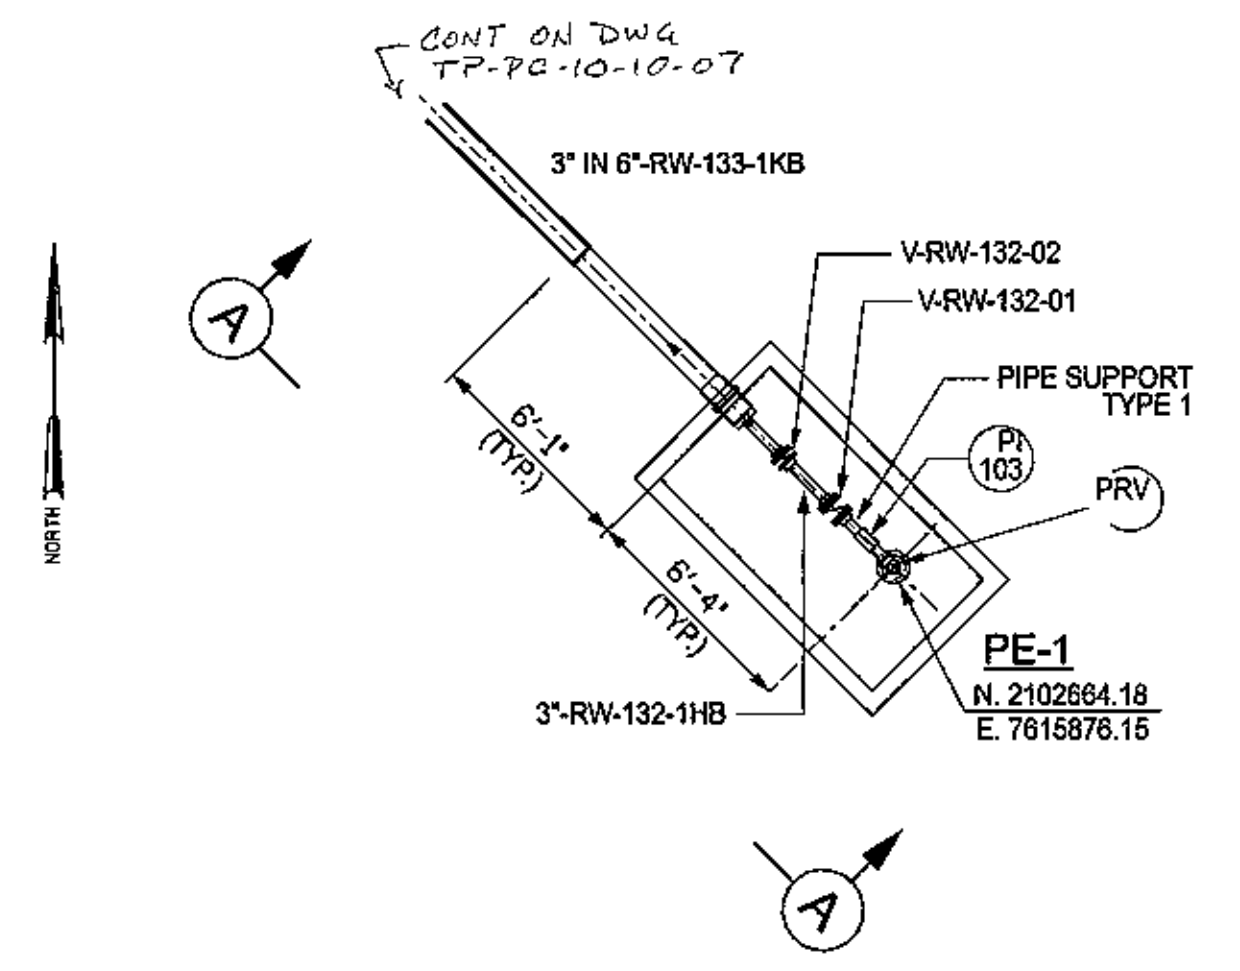

PE-1 WELL VAULT  
PIPING PLAN

 RESPONSIBLE ENGINEER: STEVEN D. HOYER PE# CA 051888 <i>Steven Hoyer</i> 7/14/05	NO.	DATE	REVISION	BY	CHK	REVISION APPROVAL	REV 0	DATE 07/14/05	PRINT DISTRIBUTION	STATUS					PACIFIC GAS & ELECTRIC CO. TOPOCK COMPRESSOR STATION INTERIM MEASURE 3 EXPANDED GROUNDWATER EXTRACTION AND TREATMENT SYSTEM PROJ NO. 315994		UNDERGROUND PIPING EXTRACTION WELLS PE-1 WELL VAULT			
	0	07/14/05	APPROVED FOR CONSTRUCTION	EFC	SDH	DISCIPLINE	REVIEWED	DISCIPLINE	REVIEWED	DATE	ISSUED	REV	DATE	SDE					PEM	
						CIVIL		ELECTRICAL		STATUS	PRELIMINARY		/ /			SCALE 1" = 20'		CH2MHILL	DWG. NO. TP-PI-20-02-06	REV. 0
						STRUCTURAL		INST & CONTRL		REV.	FOR REVIEW AND APPROVAL		/ /							
						MECHANICAL		ARCHITECTURAL		CLIENT	APPROVED FOR CONSTRUCTION	0	07/14/05	SDH						
						PROCESS		ENVIRONMENTAL		FIELD	REVISED & APPROVED FOR CONSTRUCTION		/ /							
		/ /				PIPING	SDH	GEN. ARRANG.		INTRA CD.										
		/ /																		

THIS DOCUMENT, AND THE IDEAS AND DESIGNS INCORPORATED HEREIN, AS AN INSTRUMENT OF PROFESSIONAL SERVICE, IS THE PROPERTY OF CH2M HILL AND IS NOT TO BE USED, IN WHOLE OR IN PART, FOR ANY OTHER PROJECT WITHOUT THE WRITTEN AUTHORIZATION OF CH2M HILL.



