

## Work Variance Request Form

Groundwater Remedy Phase 1 Construction, PG&E Topock Compressor Station, Needles, California

### PG&E TOPOCK GROUNDWATER REMEDIATION PROJECT

#### Work Variance Request #6 – Realignment of Pipeline F to Pipelines J and B

Request Prepared By: PG&E

Date Submitted: 5/3/19

Variance Request No.: 6

Location: Along National Trails Highway, near I-40 bridge

Request Approval From: DTSC and DOI

Date Approval Required: 5/15/19

Map Area: N/A

Landowner/Land Manager: PG&E/HNWR (managed by USFWS) Land Owner Parcel No: 650-161-08/650-161-19

Current Vegetative Cover/Land Use: Minimal along Pipelines B and J, none inside TCS

Existing Sensitive Resource? ☐ No ☒ Yes, Specify: Palo verde plants/cacti/potential ringtail cat habitat along B/J

Variance From: ☐ Mitigation Measure ☐ Work Plan/Procedure ☐ Response to Comments

☒ Drawing ☐ Permit Condition ☐ Other

#### Detailed Description of Variance and Justification (Attach additional information if necessary):

Attachments: ☐ Photo ☒ Construction Drawing ☐ Aerial Photo Mark-Up ☐ Correspondence ☐ Other

#### Potential Impacts of Variance:

- |  |  |  |
|--|--|--|
| <input type="checkbox"/> Air Quality                     | <input type="checkbox"/> Hazardous Materials         | <input type="checkbox"/> Aesthetic       |
| <input checked="" type="checkbox"/> Biological Resources | <input type="checkbox"/> Noise                       | <input type="checkbox"/> Water Resources |
| <input type="checkbox"/> Soils                           | <input type="checkbox"/> Paleo Resources             |  |
| <input type="checkbox"/> Cultural Resources              | <input type="checkbox"/> Hydrology and Water Quality |  |

#### Description and Justification:

In early October 2018, PG&E conducted a geotechnical investigation along the Pipeline F alignment on the entrance road to the Topock Compressor Station (TCS) and the adjacent hill side. Based on the geotechnical results, the construction contractor (PIVOX) indicated that soldier piles and lagging would be installed for temporary shoring. Over 40 soldier piles would be installed by drilling using a 330-sized excavator or larger. A 330-sized excavator has a general width of 11 feet, and counter weight clearance of approximately 4 feet. During operation, this rig would occupy a minimum 15 to 16 feet width of the TCS entrance road for about 12 days. The paved width of the road is between 22 to 24 feet in the area of shoring (per review of the location via Google Earth).

Assuming a minimum clearance of 1 foot (which is still less than the recommended clearance) from any operating equipment, there will be approximately 5 to 8 feet of available lane width for access by TCS traffic. Large vehicles (tractor-trailers, delivery trucks, construction equipment) will likely not be able to pass by the active operation, and passenger vehicles may also not be able to pass the active operation in locations where the road narrows. Also, the excavator cannot be repositioned while soldier piles are being drilled. In sum, access to TCS will be severely restricted for about 12 days. This is not acceptable for Compressor Station operations.

Therefore, PG&E proposes to realign Pipeline F (starting from segment F3) along the approved alignment of Pipelines B and J. Construction of Pipelines F, B, and J would occur in the same alignment and at the same time. The estimated net change in the excavated soil volumes and pipelines/conduits lengths are:

- Soil disturbance: a reduction of 1,590 cubic yards.
- Linear footage of trenches: a reduction of 1,250 feet.
- Linear footage of liquid conveyance piping: an increase of 7,832 feet (because the combined length of Pipelines J and B is 1,000 feet longer than Pipeline F)
- Linear footage of electrical conduits/communication lines: an increase of 979 feet (for same reason as above).

## Work Variance Request Form

Groundwater Remedy Phase 1 Construction, PG&E Topock Compressor Station, Needles, California

### PG&E TOPOCK GROUNDWATER REMEDIATION PROJECT

#### Work Variance Request #6 – Realignment of Pipeline F to Pipelines J and B

##### Description and Justification (Continued):

- Linear footage of liquid conveyance piping: an increase of 7,832 feet (because the combined length of Pipelines J and B is 1,000 feet longer than Pipeline F)
- Linear footage of electrical conduits/communication lines: an increase of 979 feet (for same reason as above).

There are no additional impacts to biology, historical, and cultural resources not already evaluated. Similar to previous construction work in this area, PG&E will install traffic cones to block access to the bluff above work area (see drawing C-07-69).

##### Approval Signatures:




5/3/19

PG&E Construction Manager      Date



PG&E QA Manager      Date

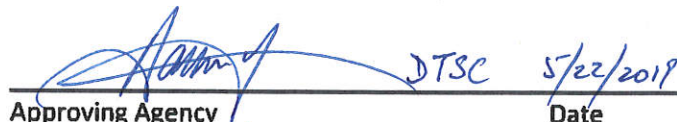

DTSC      5/22/2019

Approving Agency      Date




DOI      05/21/2019

Approving Agency      Date




Relevant Drawings from Approved Final Design (November 2015)



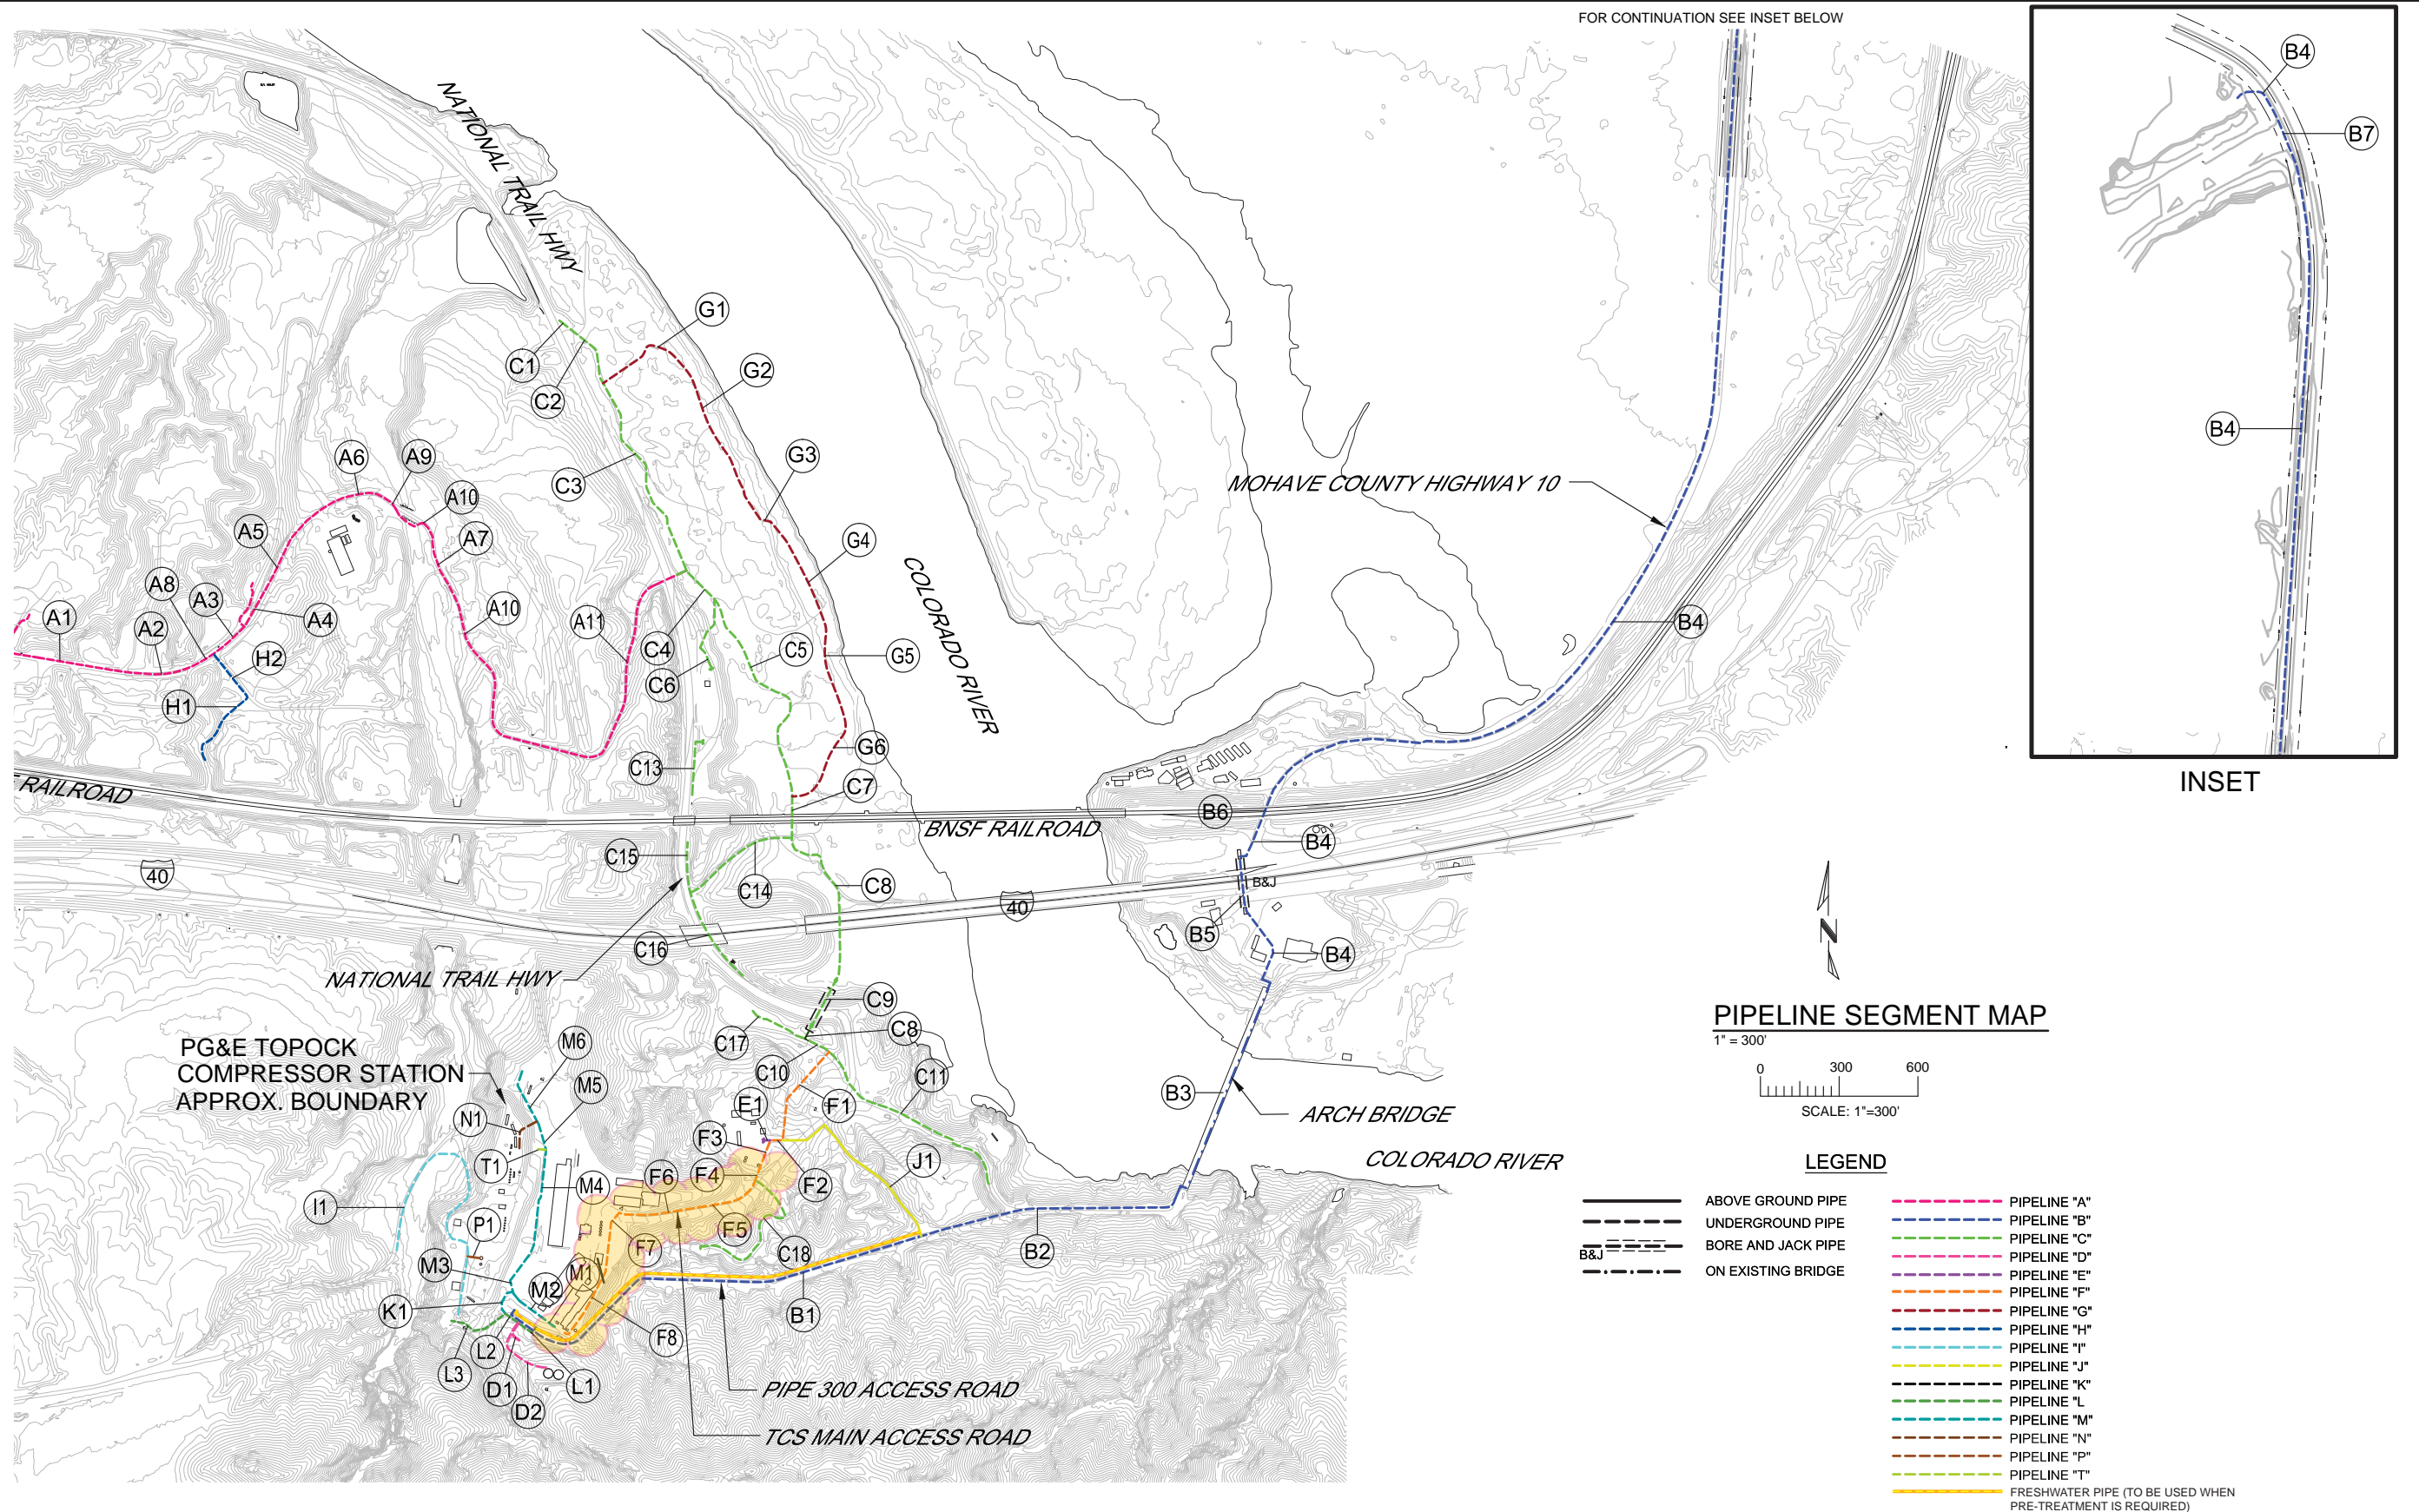


Segments of Pipeline F  
to be realigned to  
Pipelines B and J



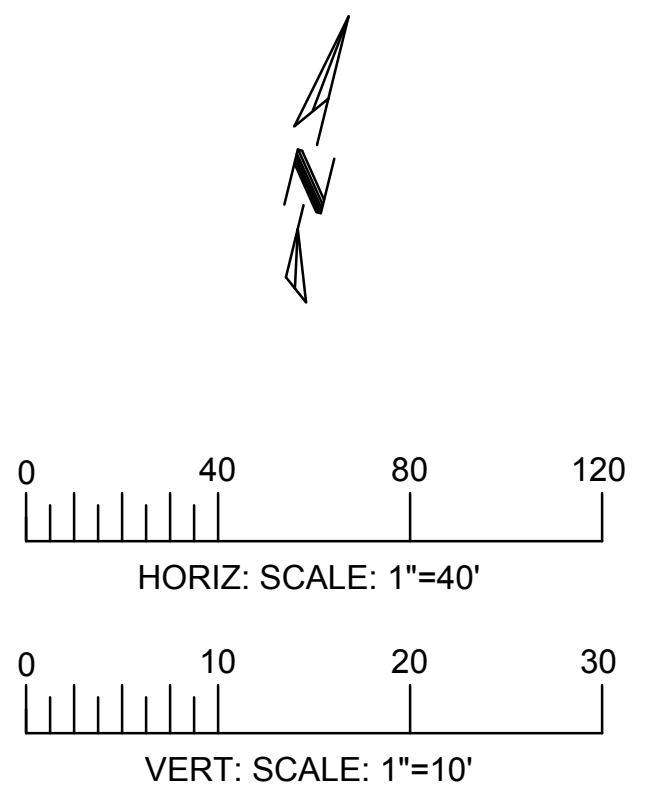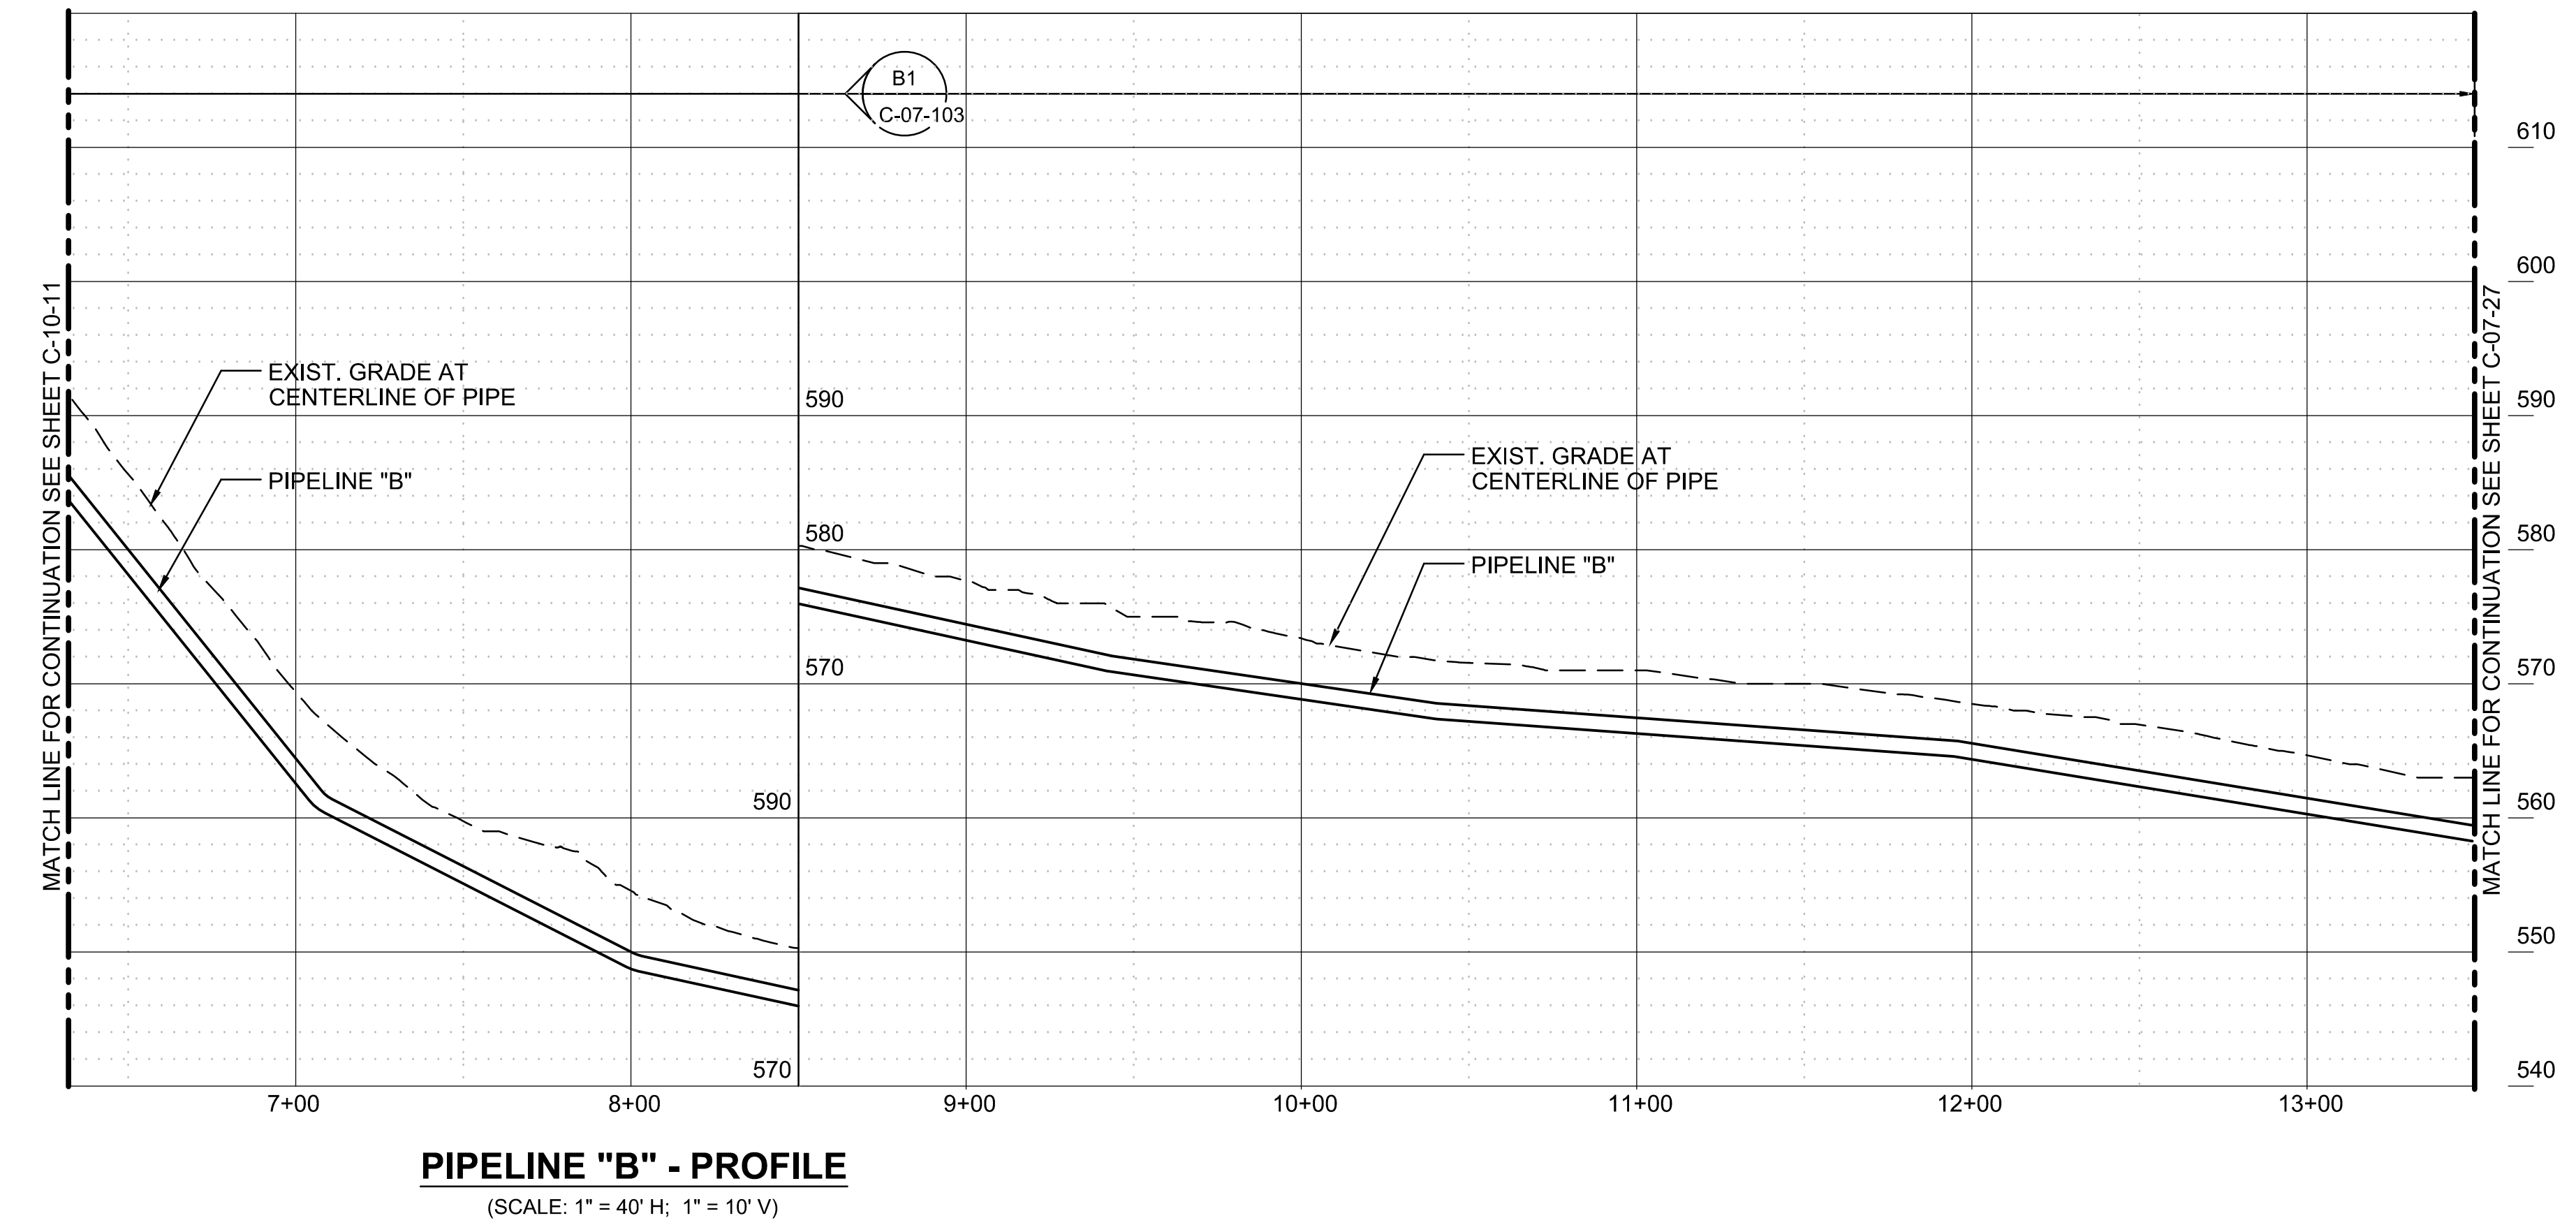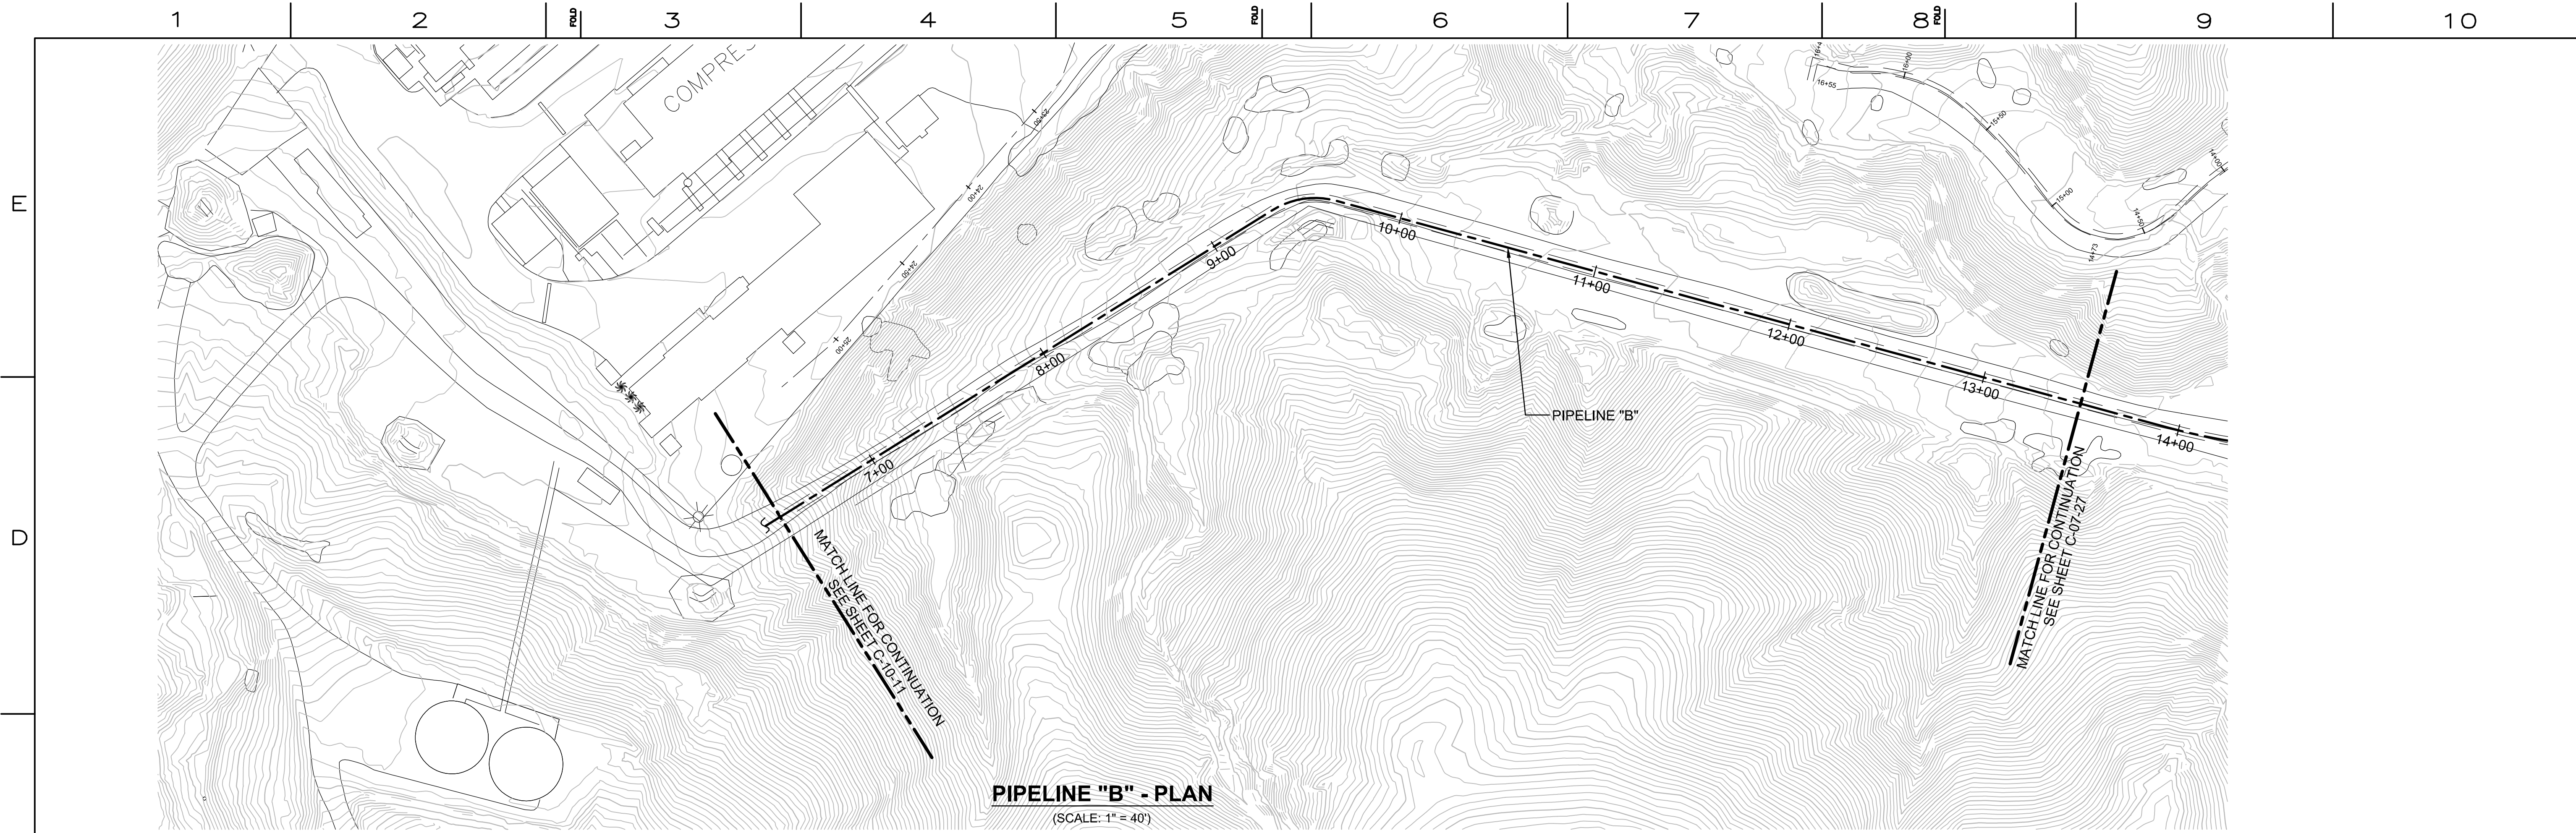

- FINAL DESIGN -  
FOR AGENCY  
APPROVAL ONLY

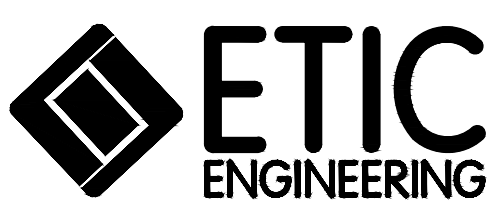

REVISIONS										REVISIONS									
NO.	DATE	DESCRIPTION	GM/SPEC	DWN	CHKD	SUPV	APVD BY	NO.	DATE	DESCRIPTION	GM/SPEC	DWN	CHKD	SUPV	APVD BY	NO.	DATE	DESCRIPTION	GM/SPEC

APPROVED BY	SO	XXXXXX
RAO	SUPV	PD
	DSGN	GO
	DWN	LD
	CHKD	JM
	OK	PD
	DATE	9/8/14
	SCALES	1" = 40'-0"

TOPOCK GROUNDWATER REMEDIATION PROJECT  
**PLAN AND PROFILE**  
**PIPELINE "B"**  
STA 3+05 TO STA 13+50  
GAS TRANSMISSION & DISTRIBUTION  
PACIFIC GAS AND ELECTRIC COMPANY  
SAN FRANCISCO, CALIFORNIA

MICROFILM		
BILL OF MATL.		
DWG LIST		
SUPSDS		
SUPSD BY		
SHEET NO.	of	SHEETS
C-07-26		3














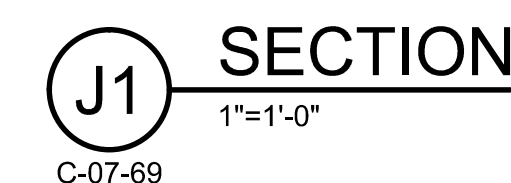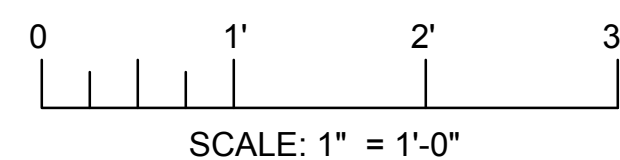

- FINAL DESIGN -  
FOR AGENCY  
APPROVAL ONLY



MICROFILM		
BILL OF MATL		
DWG LIST		
SUPSDS		
SUPSD BY		
SHEET NO.	of	SHEETS
C-07-107		REV 2

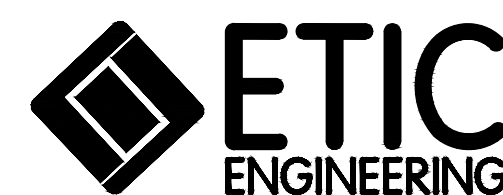[illegible]

APPROVED BY	SO	
RAO	SUPV	
	DSGN	
	DWN	
	CHKD	
	OK	
	DATE	
	SCALES	


## PIPELINE SECTIONS

GAS TRANSMISSION & DISTRIBUTION  
PACIFIC GAS AND ELECTRIC COMPANY  
SAN FRANCISCO, CALIFORNIA



REVISED DRAWINGS FOR WORK VARIANCE REQUEST #6



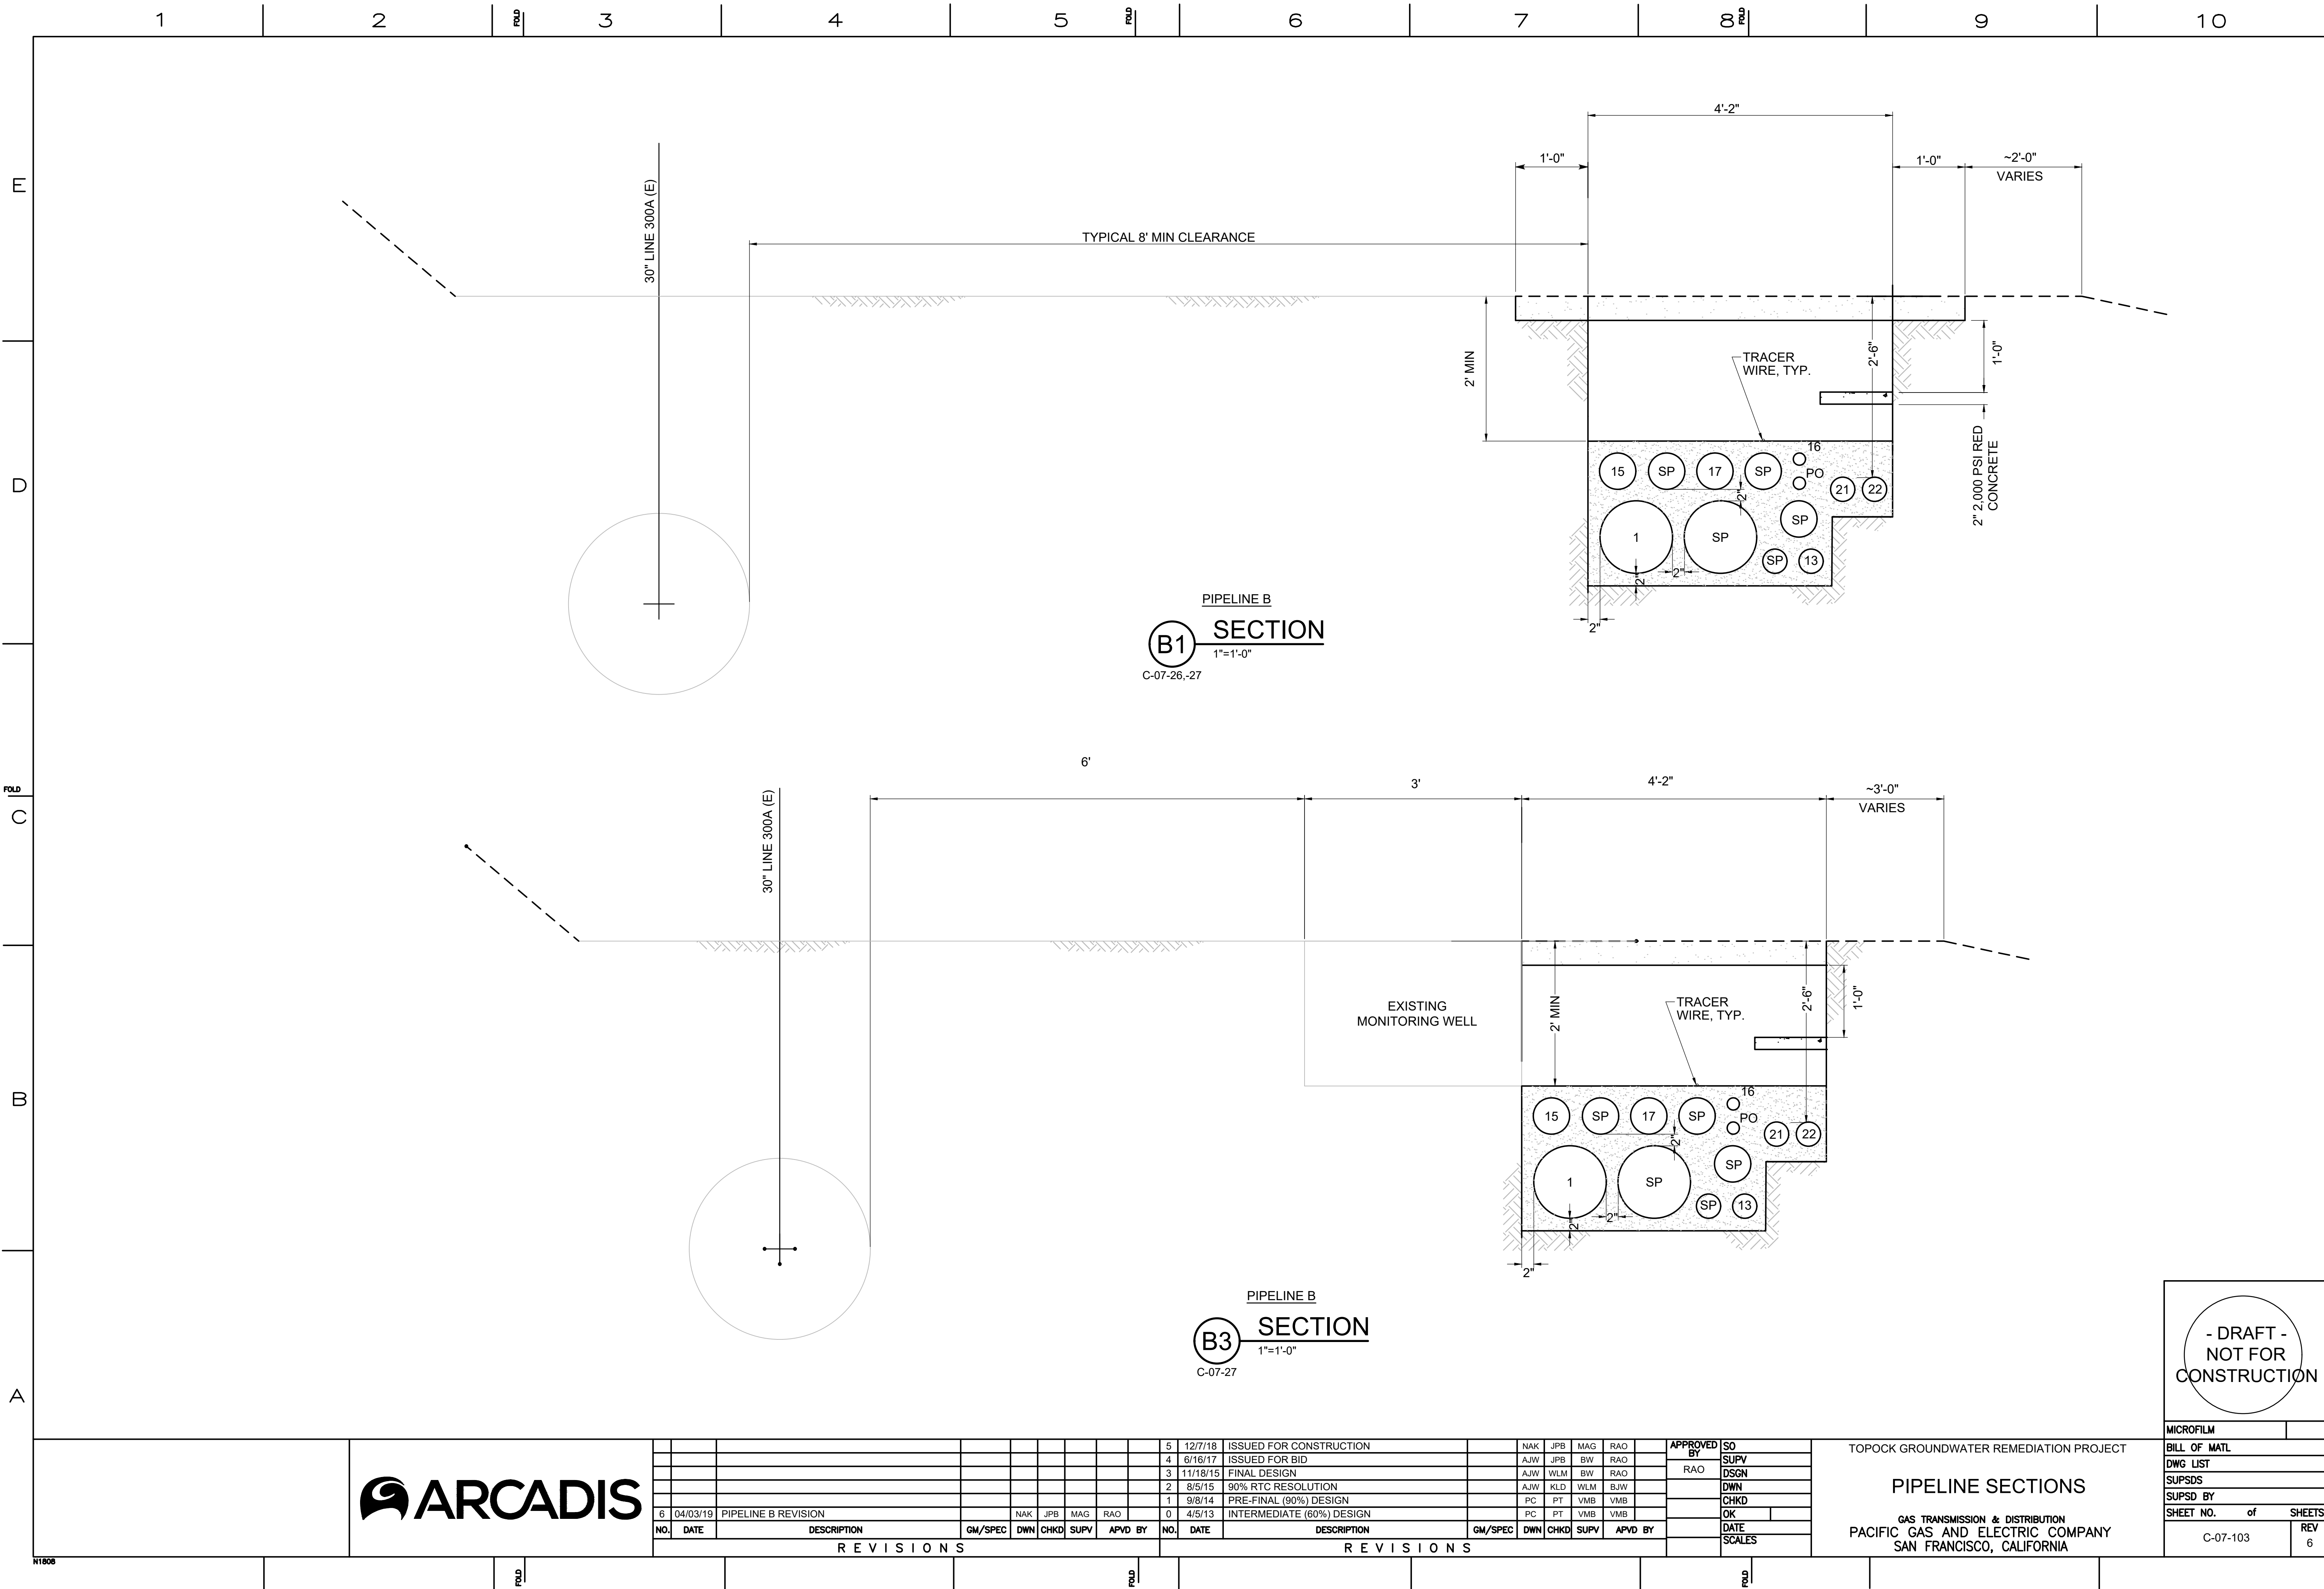

PIPELINE B  
**B1** SECTION  
1"=1'-0"  
C-07-26,-27

PIPELINE B  
**B3** SECTION  
1"=1'-0"  
C-07-27

- DRAFT -  
NOT FOR  
CONSTRUCTION

MICROFILM

BILL OF MATL

DWG LIST

SUPSDS

SUPSD BY

SHEET NO. of SHEETS


C-07-103 REV 6

TOPOCK GROUNDWATER REMEDIATION PROJECT

**PIPELINE SECTIONS**

GAS TRANSMISSION & DISTRIBUTION  
PACIFIC GAS AND ELECTRIC COMPANY  
SAN FRANCISCO, CALIFORNIA

										5	12/7/18	ISSUED FOR CONSTRUCTION			NAK	JPB	MAG	RAO		APPROVED BY  RAO	SO																																		
										4	6/16/17	ISSUED FOR BID			AJW	JPB	BW	RAO			SUPV																																		
										3	11/18/15	FINAL DESIGN			AJW	WLM	BW	RAO			DSGN																																		
										2	8/5/15	90% RTC RESOLUTION			AJW	KLD	WLM	BJW			DWN																																		
										1	9/8/14	PRE-FINAL (90%) DESIGN			PC	PT	VMB	VMB			CHKD																																		
6	04/03/19	PIPELINE B REVISION						NAK	JPB	MAG	RAO				0	4/5/13	INTERMEDIATE (60%) DESIGN			PC	PT	VMB	VMB		OK																														
NO.	DATE	DESCRIPTION						GM/SPEC	DWN	CHKD	SUPV	APVD	BY	NO.	DATE	DESCRIPTION						GM/SPEC	DWN	CHKD	SUPV	APVD	BY	DATE																											
R E V I S I O N S																												R E V I S I O N S																											
DATE SCALES	

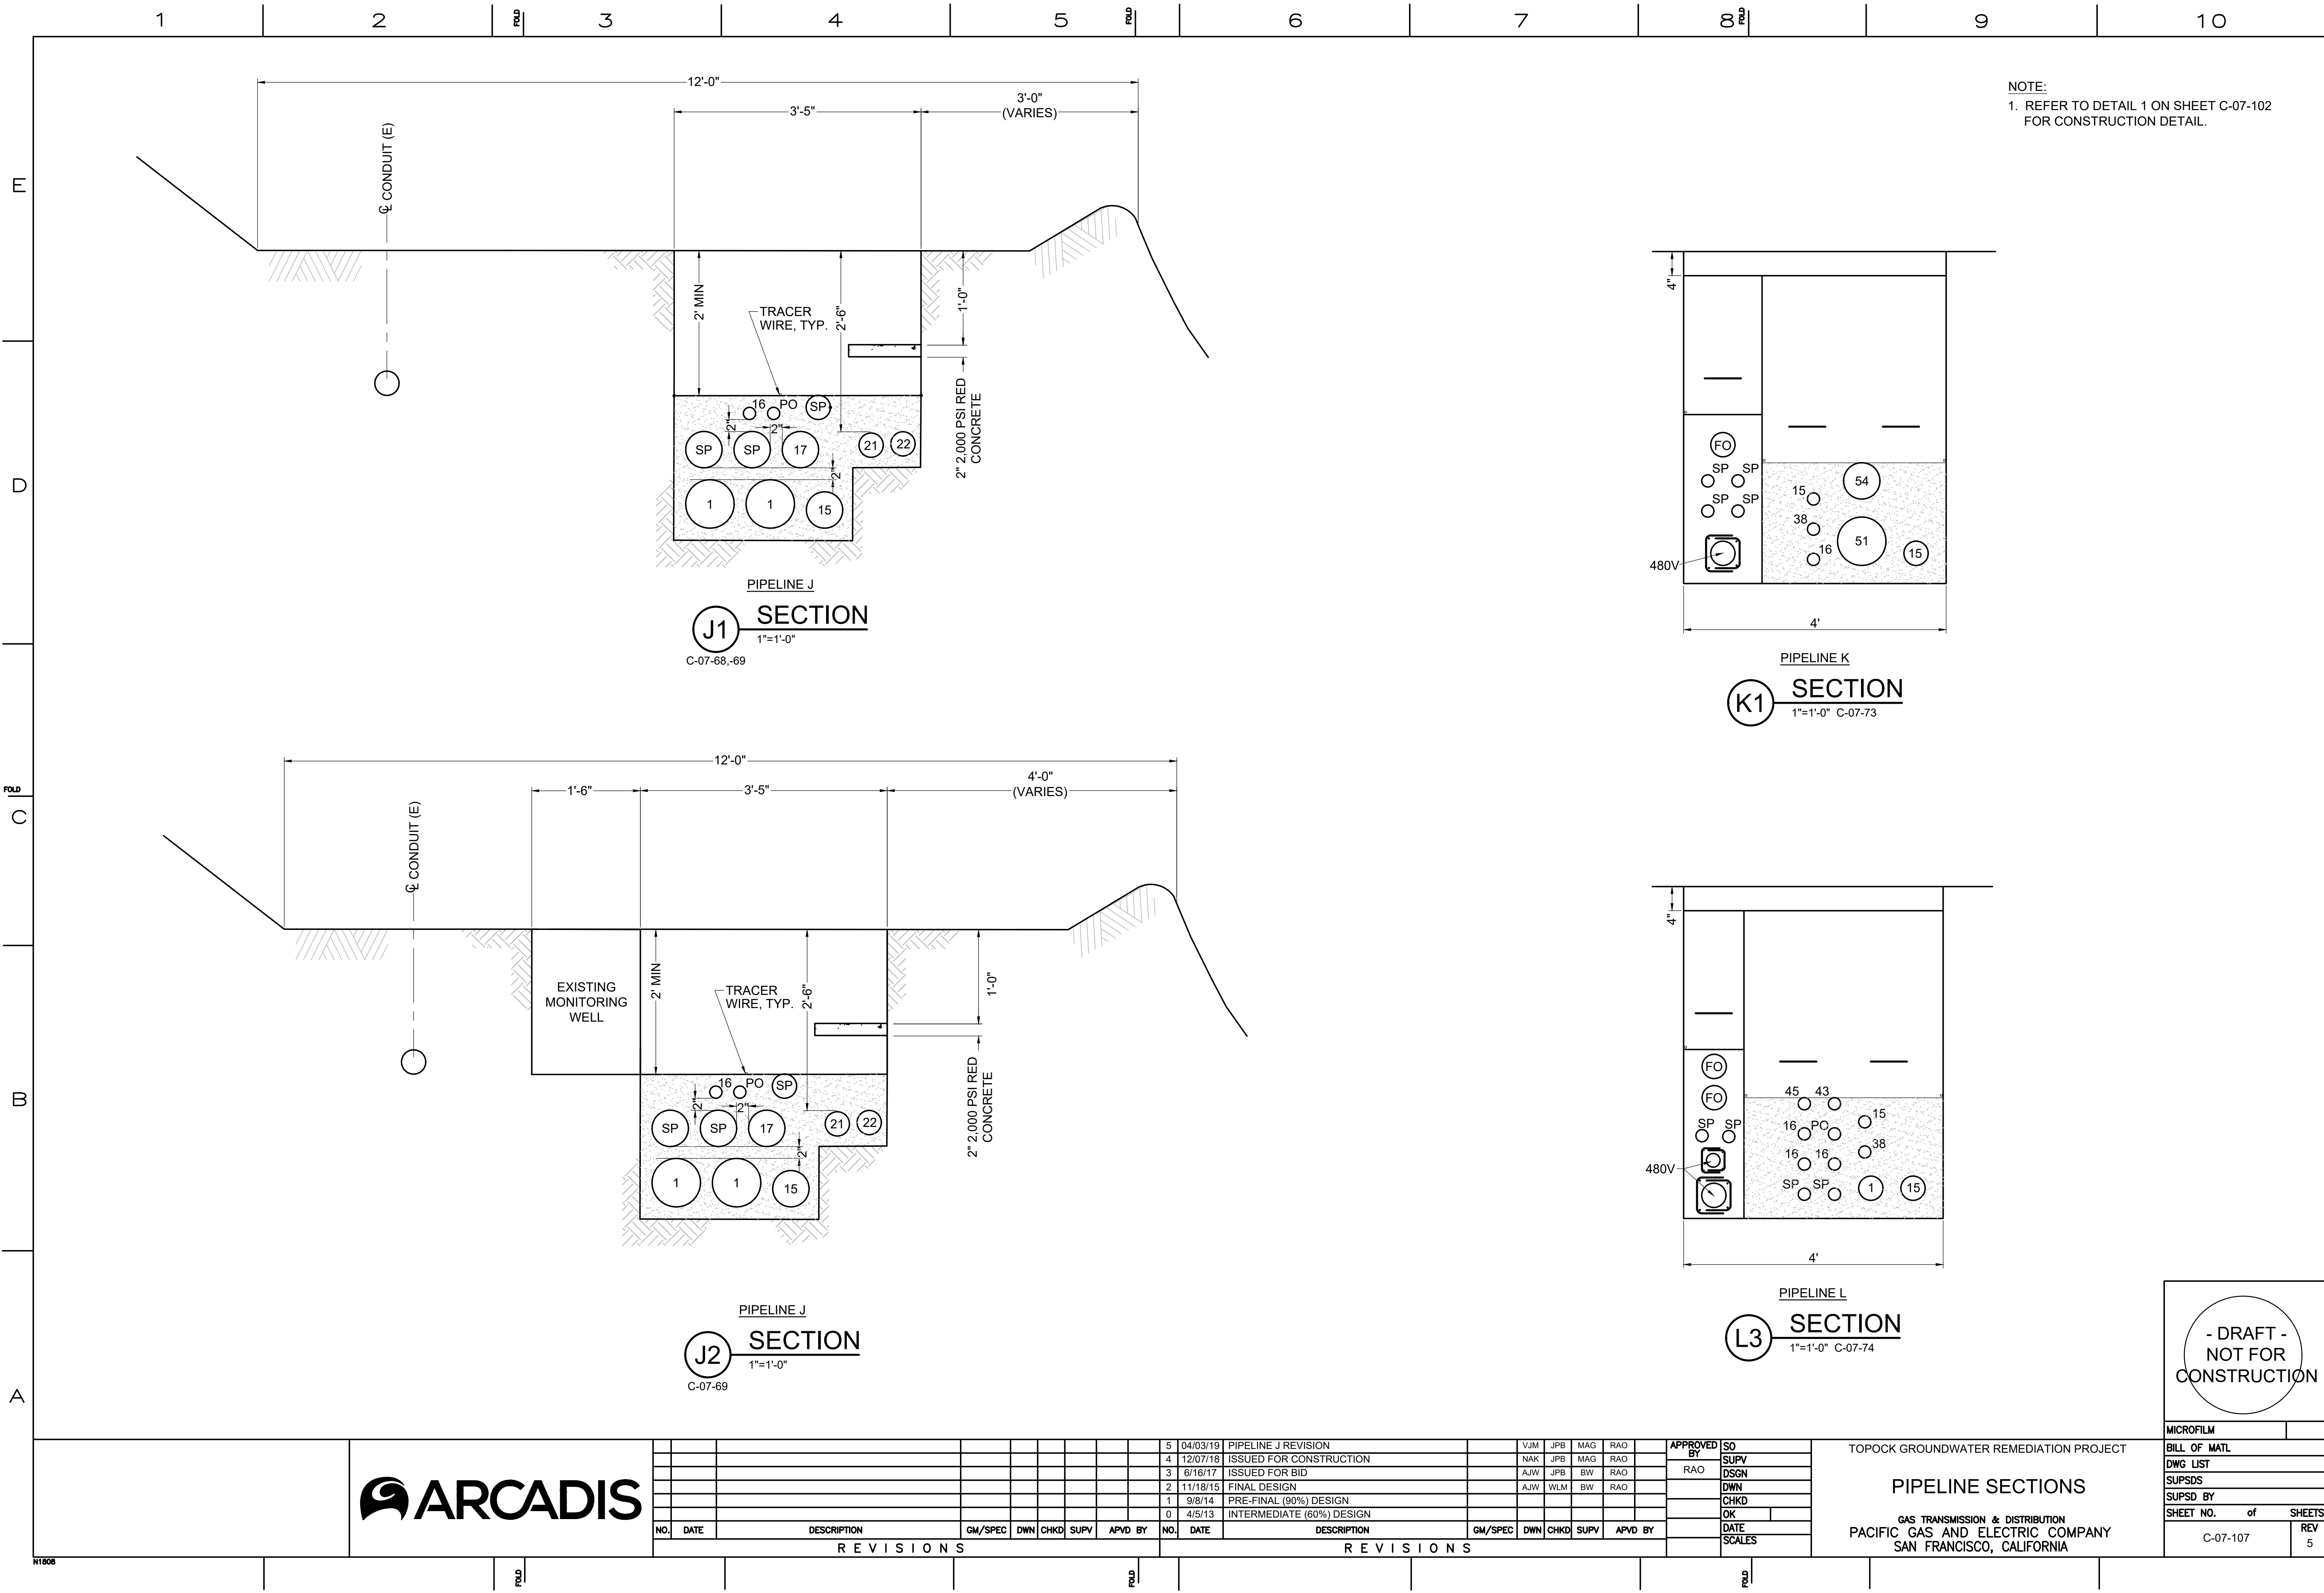

- DRAFT -  
NOT FOR  
CONSTRUCTION

MICROFILM

BILL OF MATL

DWG LIST

SUPSDS

SUPSD BY

SHEET NO. of SHEETS

C-07-107 REV 5

										5	04/03/19	PIPELINE J REVISION		VJM	JPB	MAG	RAO		APPROVED BY	SO
										4	12/07/18	ISSUED FOR CONSTRUCTION		NAK	JPB	MAG	RAO		BY	SUPV
										3	6/16/17	ISSUED FOR BID		AJW	JPB	BW	RAO		RAO	DSGN
										2	11/18/15	FINAL DESIGN		AJW	WLM	BW	RAO			DWN
										1	9/8/14	PRE-FINAL (90%) DESIGN								CHKD
										0	4/5/13	INTERMEDIATE (60%) DESIGN								OK
																				DATE
																				SCALES

TOPOCK GROUNDWATER REMEDIATION PROJECT

PIPELINE SECTIONS

GAS TRANSMISSION & DISTRIBUTION  
PACIFIC GAS AND ELECTRIC COMPANY  
SAN FRANCISCO, CALIFORNIA



## Future Activity Allowance Determination Matrix for Work Variance Request (WVR)

Work Variance Request No. 6

Date: 5/3/19

Future Activity Allowance is an activity that is not considered in the remedy design but necessary to support the project objectives. Future Activity Allowance is a Material Deviation which is defined in the final groundwater remedy design as: Material Deviation means a change or correction required to prevent a condition that would (1) render the approved design non-compliant with codes, regulations, and /or engineering standard of practices, (2) render planned well locations and/or constructions fail to meet the project objectives, (3) cause significant schedule delay, and/or (4) cause a significant increase in costs. (CH2M Hill, 2015)

According to the SEIR Project Description, "The inclusion of the Future Activity Allowance is not intended to account for minor adjustments (work variances) of the remedy design during construction resulting from field conditions. DTSC's objective for the inclusion of the Future Activity Allowance is to consider the potential impacts of needing to take additional but previously unforeseen activities that were not contemplated as part of the Final Remedy Design but are activities that would improve the performance of the remedy, or are necessary to gather additional information on the remedy performance, and/or aid in the transition of the active remedy to monitored natural attenuation." (ESA, 2017)

---

1. Are all components of the WVR in the approved final design as reviewed in the SEIR?

☒ Yes ☐ No

2. Are all components of the WVR staying within an infrastructure alignment in the approved final design?

☒ Yes ☐ No

If answers to both 1 and 2 are Yes, STOP – action is not Future Activity Allowance

3. For components not in approved final design, will the WVR require new access not identified for use in the final design and create new ground disturbance beyond those anticipated in final design?

☐ Yes ☐ No

If answer is No, STOP – action is not Future Activity Allowance. If Yes, proceed...

4. For components not in approved final design and require new access or new ground disturbance, will the ground disturbing activity be outside the 2018 SEIR project boundary?

☐ Yes ☐ No

If answer is Yes, STOP – action is subject to additional CEQA evaluation. WVR approval will be considered after DTSC completes CEQA determination.

5. For WVR requiring new access and/or new ground disturbance, but project components are in approved final design and within the 2018 SEIR project boundary, is the variance necessitated by field conditions which are outside the control of the operator (e.g. refusal during drilling, unstable ground, existing design jeopardizes health and safety, modification to avoid archaeological resource, existing design does not conform to engineering standards, etc.)?

☐ Yes ☐ No

If answer is No or otherwise explained in Section 7 below, action is Future Activity Allowance, follow Communication Protocol for Future Activities Allowance, Exhibit 3 to the Statement of Decision and Resolution of Approval. If the answer is Yes, action is Future Activity Allowance, and DTSC will work with



Future Activity Allowance Determination Matrix

WVR No. 6

Page 2 of 2

Tribes to meet the time sensitivity of the WVR. Regardless of response, because of new access and/or new ground disturbance, WVR action may be subject to Federal Consultation. Inquire with BLM to determine whether there is a need to follow Consultation during Construction protocol.

6. Does the addition of WVR cause an exceedance from infrastructure limits specified in the 2018 certified Final SEIR (Table 3-1 for well boreholes; Table 3-2 for pipeline trenches, electrical/communication conduit, roadway improvements, or sizes of buildings and structures; Table 3-4 for volume of soil disturbance and Table 3-5 for water usage)?

☐ Yes ☐ No

If answer is Yes, STOP – action is subject to additional CEQA evaluation. WVR approval will be considered after DTSC completes a CEQA checklist to determine if there are new or substantially more significant environmental impacts than disclosed in the 2018 SEIR.

7. Other extenuating circumstances or information for FAA considerations: ☐ No

☐ Yes – provide information and/or justification

Conclusion: WVR No. 6

☒ is not a FAA ☐ is a FAA

Signature of DTSC reviewer: \_\_\_\_\_



Date: 05/22/2019